


T.15S., R.16E., W.M.

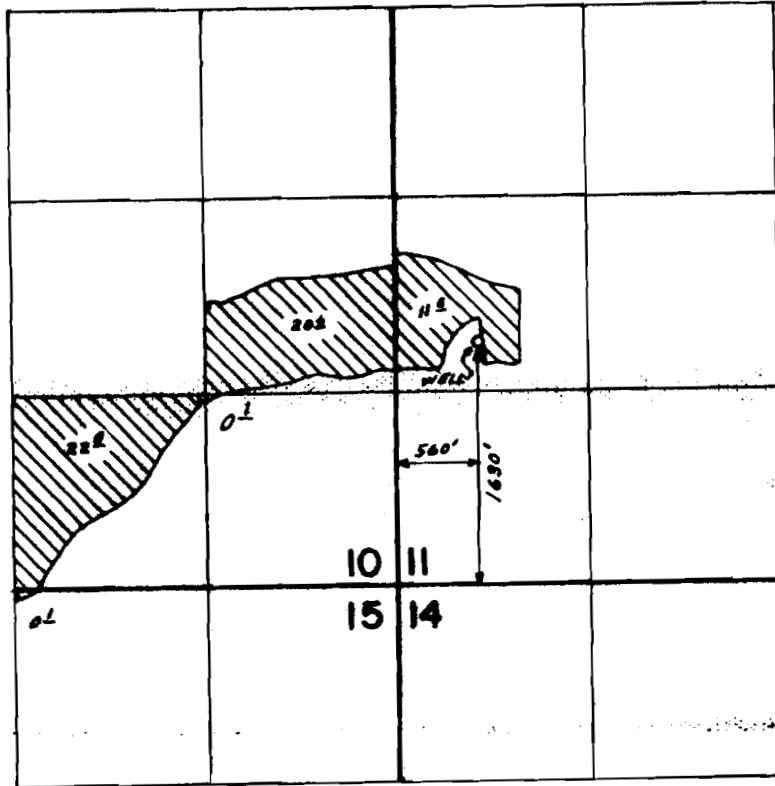

SCALE: 1"=1320'

FINAL PROOF SURVEY UNDER

Application No. G-9630 Permit No. G-9498
IN NAME OF

MARTIN I. HOWARD

Surveyed JUN 13 1988, by B. BISHOP

Cert. # 63679

RECEIVED

DATE 1-26-90

WATER MASTER DISTRICT #11

BY SMJ

G-9498
11-4-88

41013-180-141L LLC