


G-9461
63681

T.39S., R.19E., W.M.

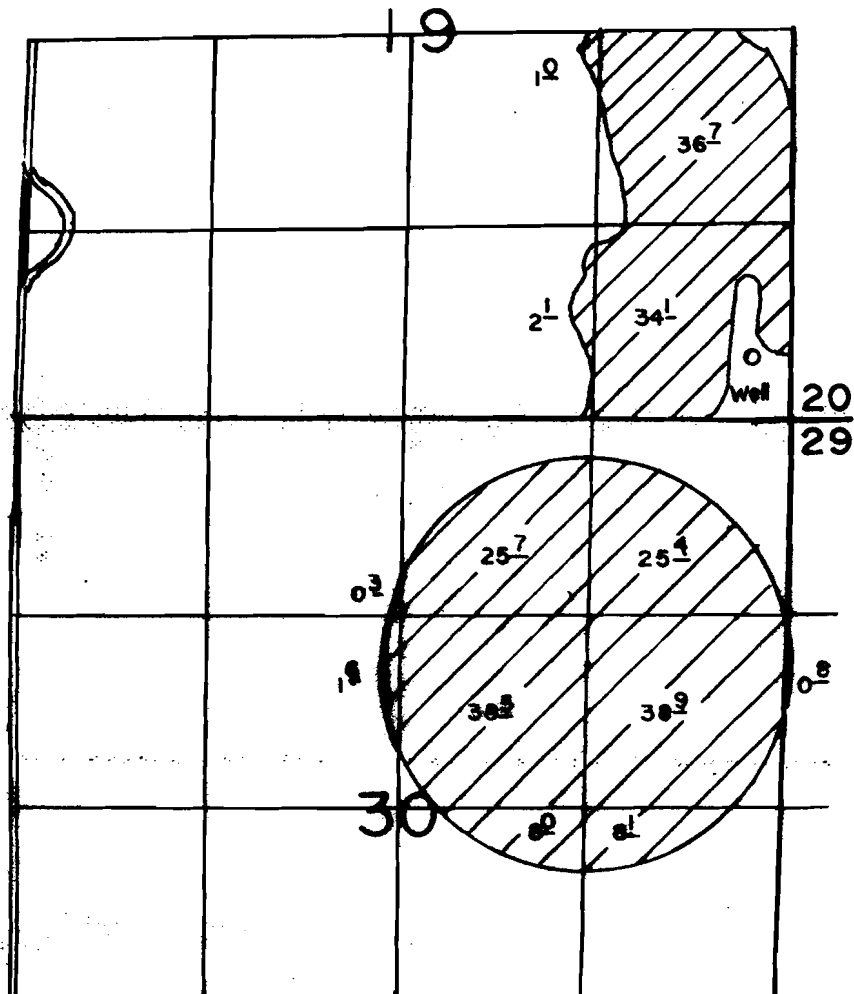

Well Located 420' N & 250' W From SE Corner Section 19

SCALE: 1"=1320'

FINAL PROOF SURVEY UNDER

Application No. G-9774, Permit No. G-9461.....
IN NAME OF

.....WEIN M. GROTHE JR.....

Surveyed OCT. 17, 1987, by T.M. WARREN.....