


T.15S., R.13E., WM.

RECEIVED

MAY 18 1985

WATER RESOURCES DIVISION
U.S. GEOLOGICAL SURVEY

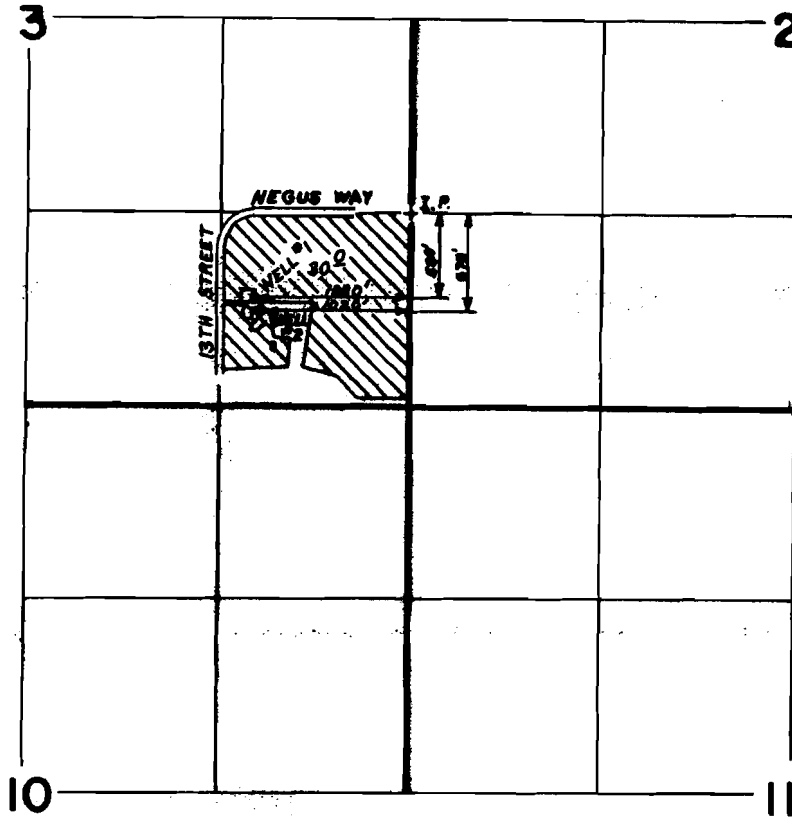

SCALE: 1" = 1320'

FINAL PROOF SURVEY
UNDER

Application No. G-9840 Permit No. G-10313

IN NAME OF

ORVAIL BUCKNER

Surveyed APR. 30 1985, by LESLIE OLSON

Cert. # 63682

RECEIVED
 DATE 1-26-90
 WATER MASTER DISTRICT #11
 BY SMJ

G-10313