


T. 23 & 24S., R. 33E., W.M.

34

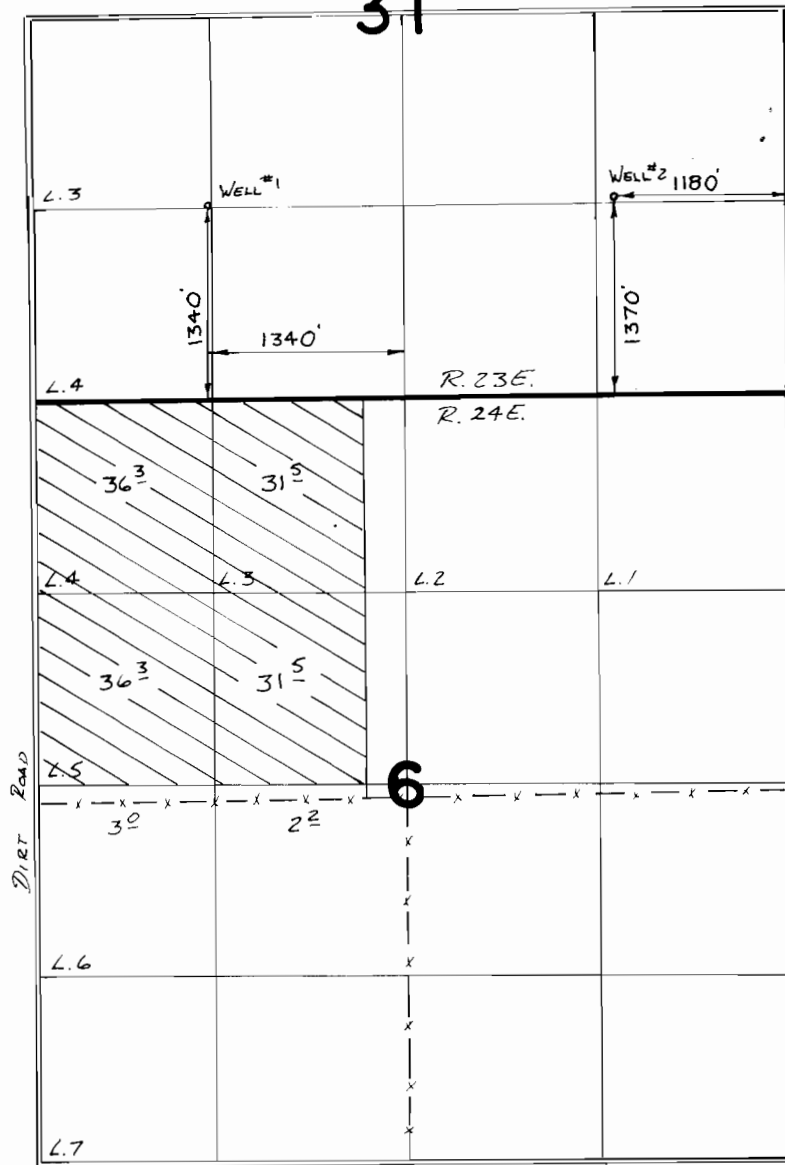

Scale 1" = 1320'

FINAL PROOF SURVEY

UNDER

Application No. **G-9872** Permit No. **G-9061**
IN NAME OF

DONALD E. JORGENSEN

Surveyed 5-6 1988, by V.L. Church

41025-279-1214

11-23-88 VLC