


T. 35 S., R. 2 W., W. M.

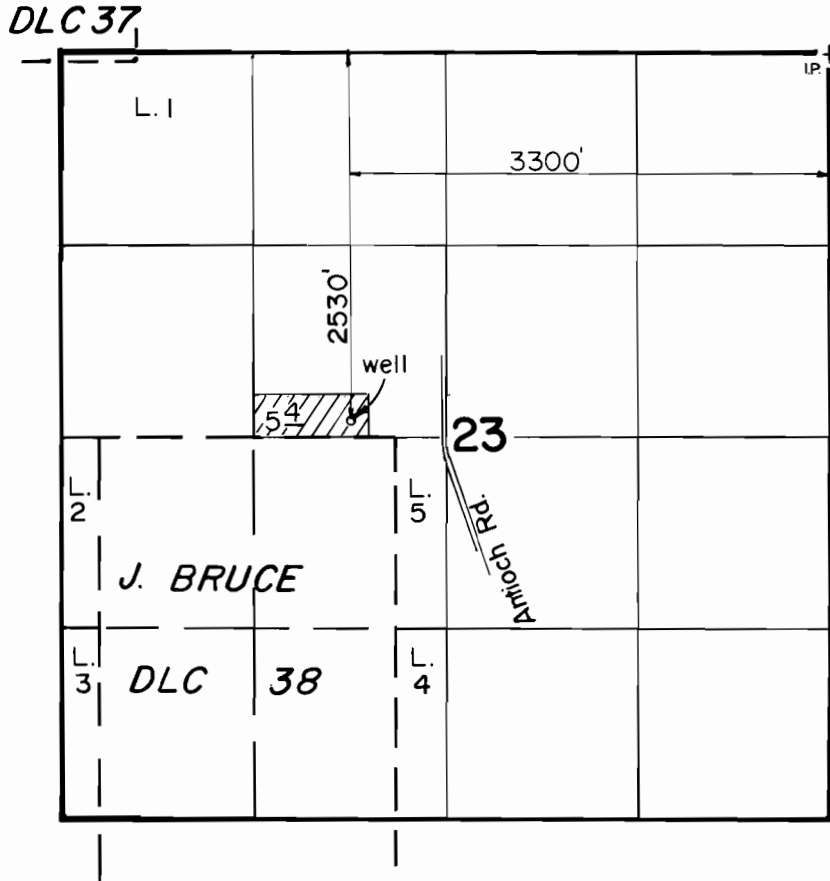

Scale: 1" = 1320'

FINAL PROOF SURVEY

UNDER

Application No. G-9875 Permit No. G-9386
IN NAME OF

WILLIAM D. &/or ONA LAWRENCE

Surveyed APR. 18, 1988, by B. S. JAMES