


T.16 & 17 S., R.3 W., W.M.

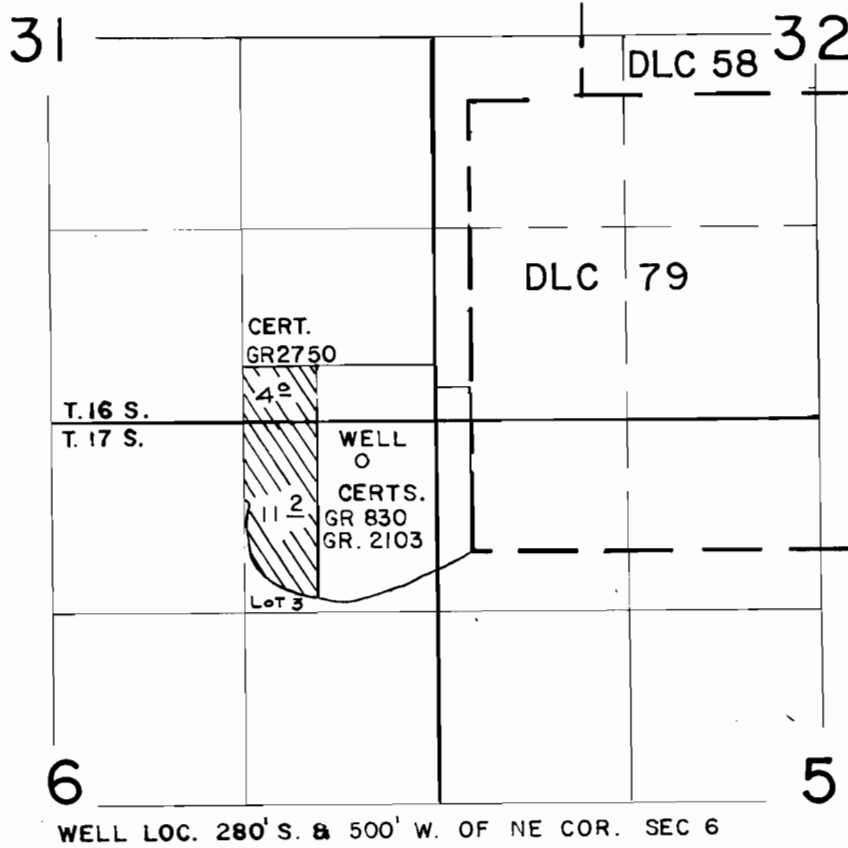

SCALE  
1" = 1320'

### FINAL PROOF SURVEY UNDER

Application No. G10029 Permit No. G.9832....  
IN NAME OF

VICTOR LANINI

Surveyed JUL 18 1984, by P. PAGTER