


T.18S., R.11 & 12E., W.M.

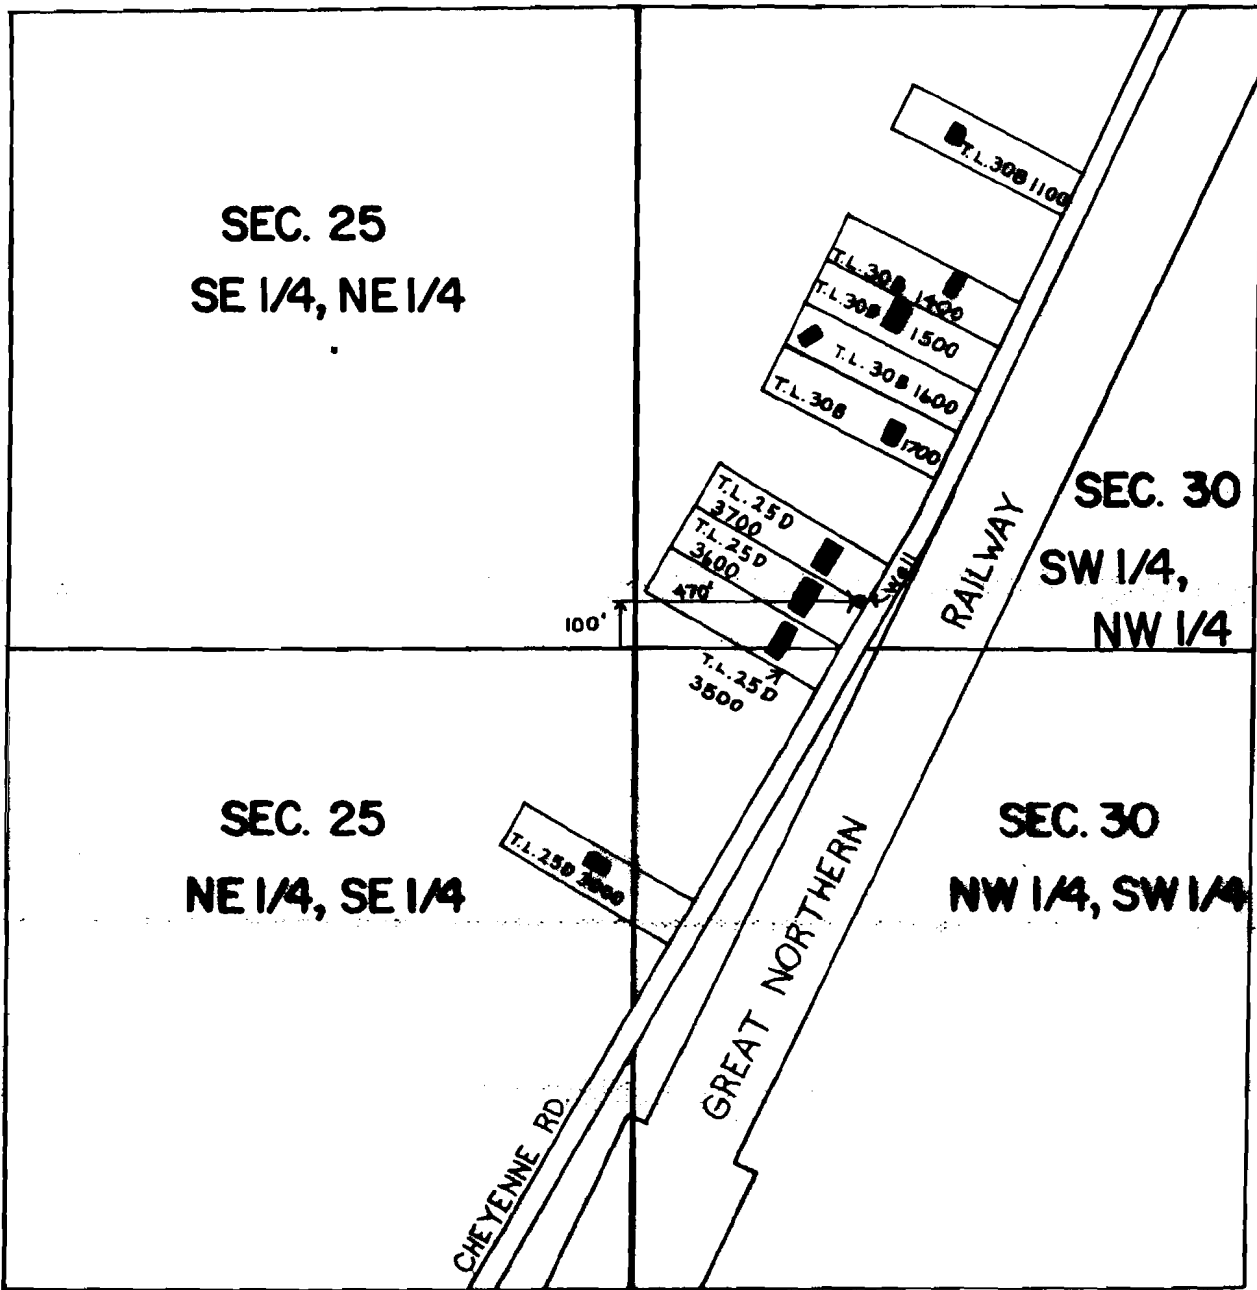

SCALE: 1" = 400'

FINAL PROOF SURVEY
UNDER

Application No. G-10445 Permit No. G-9976
IN NAME OF

Cont. # 63686

AVION WATER CO.

Surveyed Sept. 11 & 12 1986, by M.J. MATTICK
and Mar. 6, 1987

RECEIVED

DATE 1-26-90
WATER MASTER DISTRICT #11
BY SM



G9976
App. Map MJM