


T.1&2S. R.12&13E. W.M.

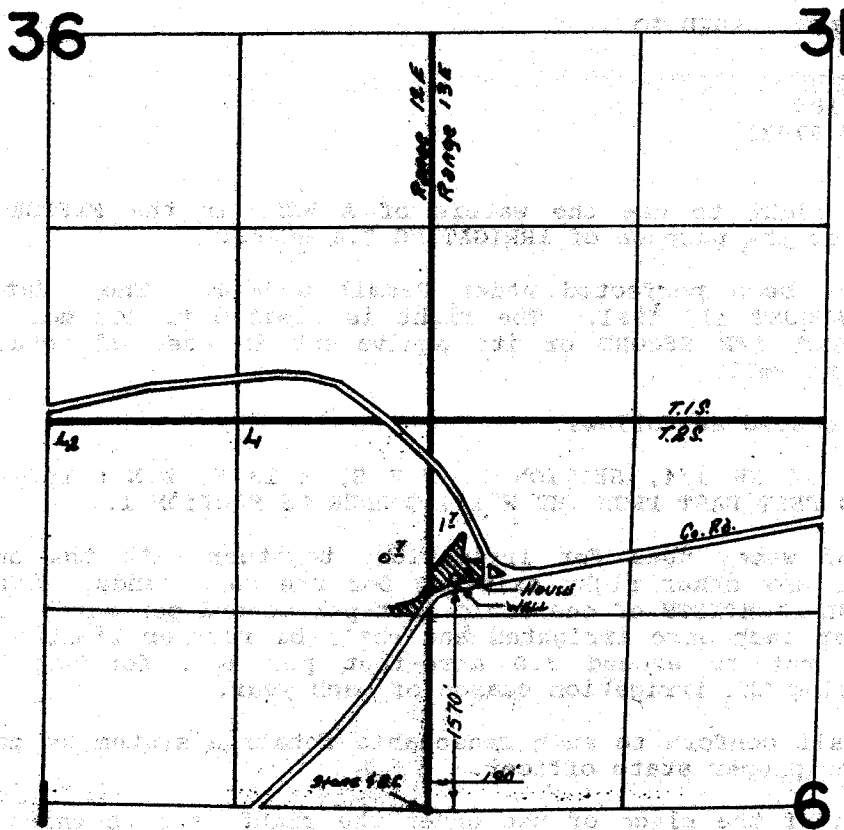

FINAL PROOF SURVEY
UNDER

Application No. G-10509 Permit No. G-9848
IN NAME OF

JERRY P. WELP

Surveyed July 13, 1983, by T. J. Paul