



T.16S., R.5W., W. M.

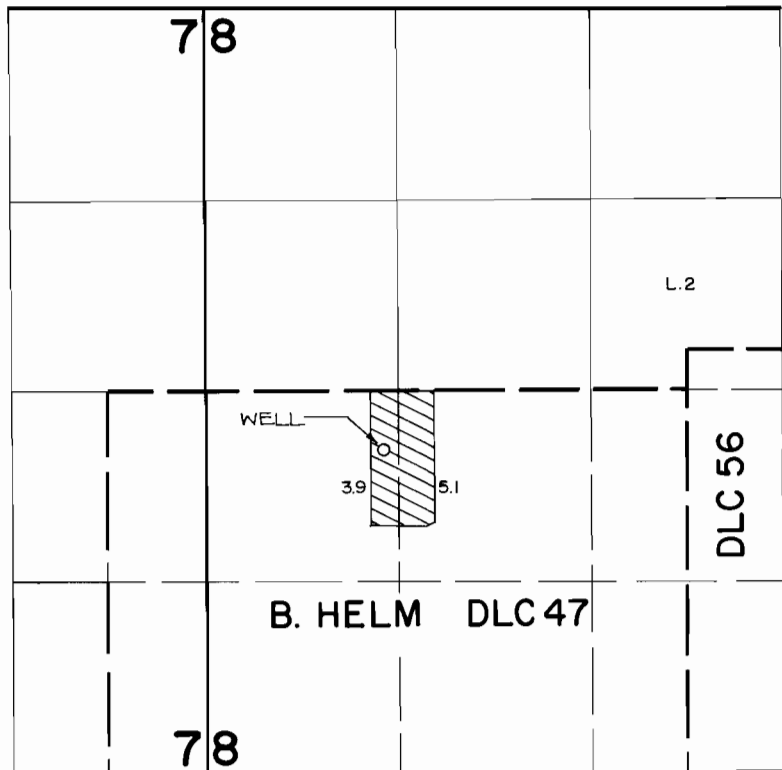

WELL LOCATION: 2220 FT. N. AND 1220 FT. E. FROM
THE S.W. CORNER OF SECTION 8.

FINAL PROOF SURVEY

UNDER

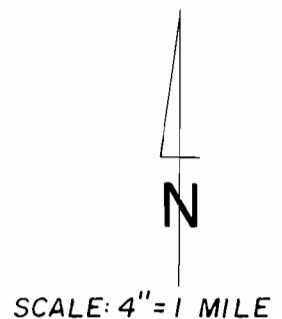

Application No. G-10573 Permit No. G-9851.....
IN NAME OF

.....BRUCE C. LENMARK.....

Surveyed MAY 9, 1984, by P. Porter.....