




T. 15 S., R. 42 E., W.M.

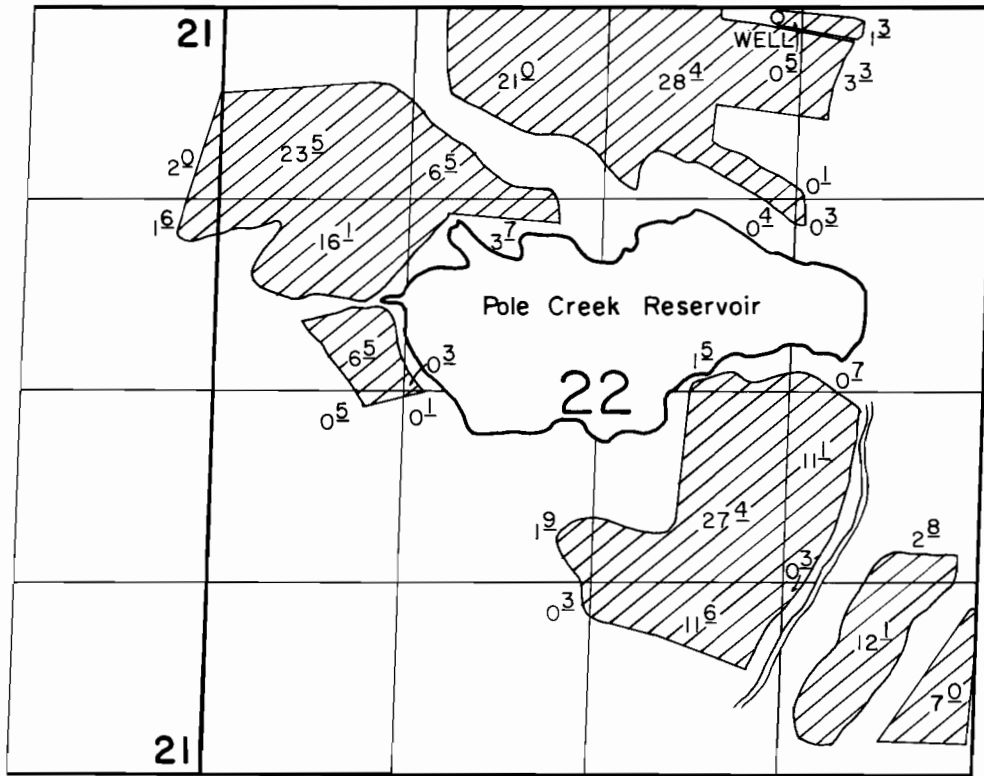

WELL LOC: 50' S. & 1500' W. FROM NE. CORNER SECTION 22

SCALE: 1" = 1320'

### FINAL PROOF SURVEY UNDER

Application No. G-10575. Permit No. G-9810.....  
IN NAME OF

MARK C. & SHARON L. VILSMEYER

Surveyed JUNE 17, 1986, by V. CHURCH.....