


6-9781
63691

T. 6N., R. 35E., W. M.

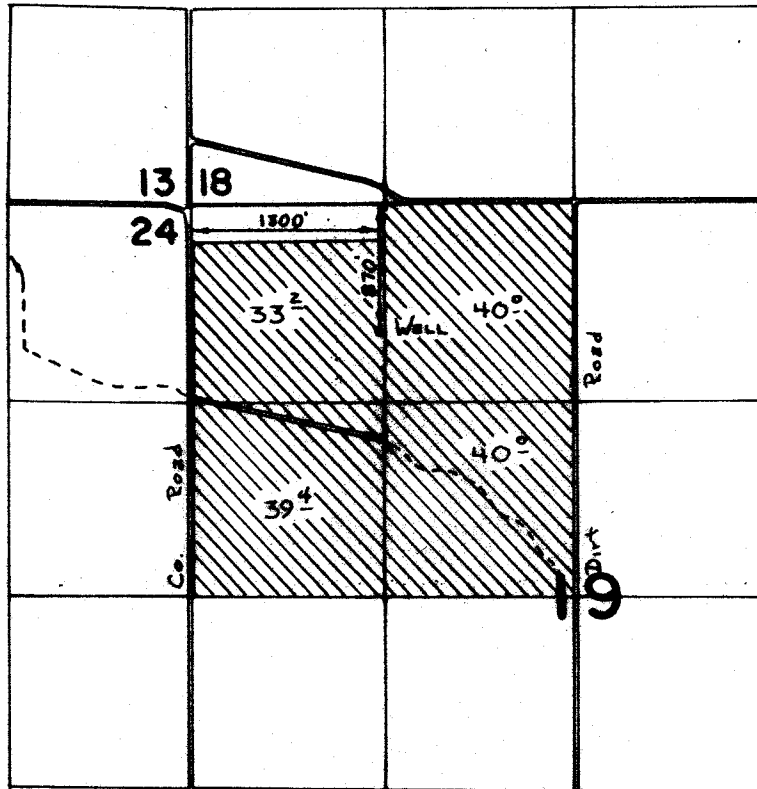

FINAL PROOF SURVEY
UNDER

Application No. G:10638 Permit No. G:9781....
IN NAME OF

RUTH C. & RHEA M. GRAY

Surveyed Jan 4 1925, by V. L. Church