


T. 35 S., R. 4 W., W.M.

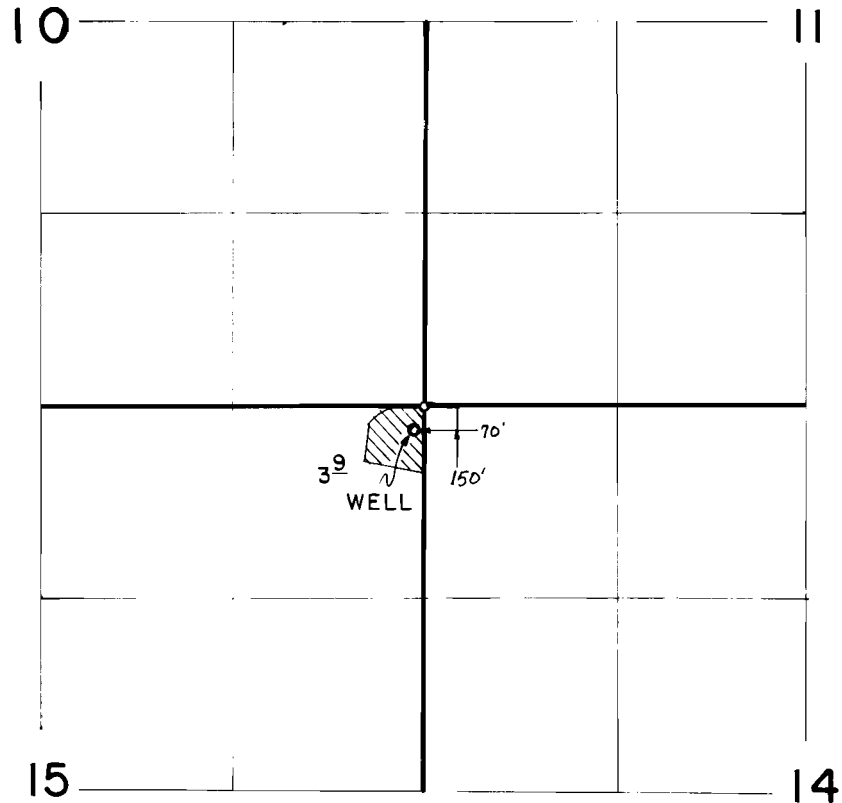

FINAL PROOF SURVEY
UNDER

Application No. ~~G.10694~~ Permit No. ~~G.9950~~....
IN NAME OF

ANTHONY D. &/OR MAXINE M. LENTINI

Surveyed DEC. 12, 1983, by B. S. JAMES.....