


T. 35 S., R. 1 W., W.M.
SEC. 22

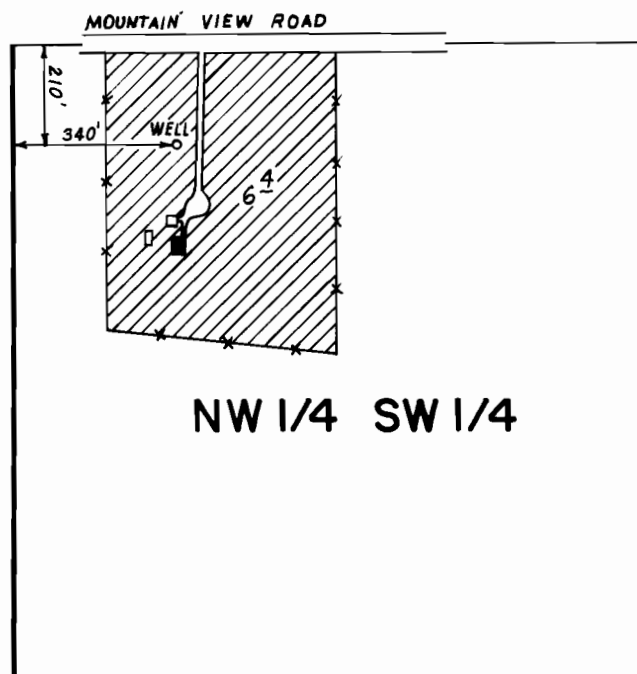

SCALE: 1" = 400'

FINAL PROOF SURVEY
UNDER

Application No. **G-10735** Permit No. **G-9857**
IN NAME OF

CHARLES & PATRICIA KILPATRICK

Surveyed **JULY 6** 19**83**, by **B. S. JAMES**