


G-9955
63697

T. 4N., R. 29E., W.M.

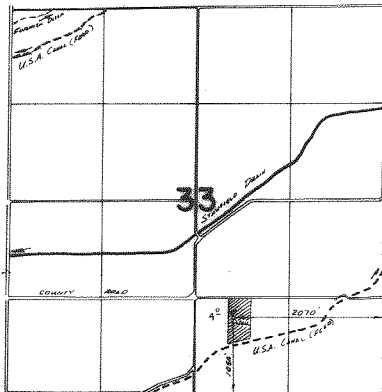

FINAL PROOF SURVEY
UNDER

Application No. ~~G:10773~~ Permit No. ~~G:9955~~
IN NAME OF

.....GILBERT G. GETTMANN.....

Surveyed ~~MAY 2~~ 19~~83~~, by ~~R.H. [unclear]~~.....