


T.3S., R.2W., W.M.

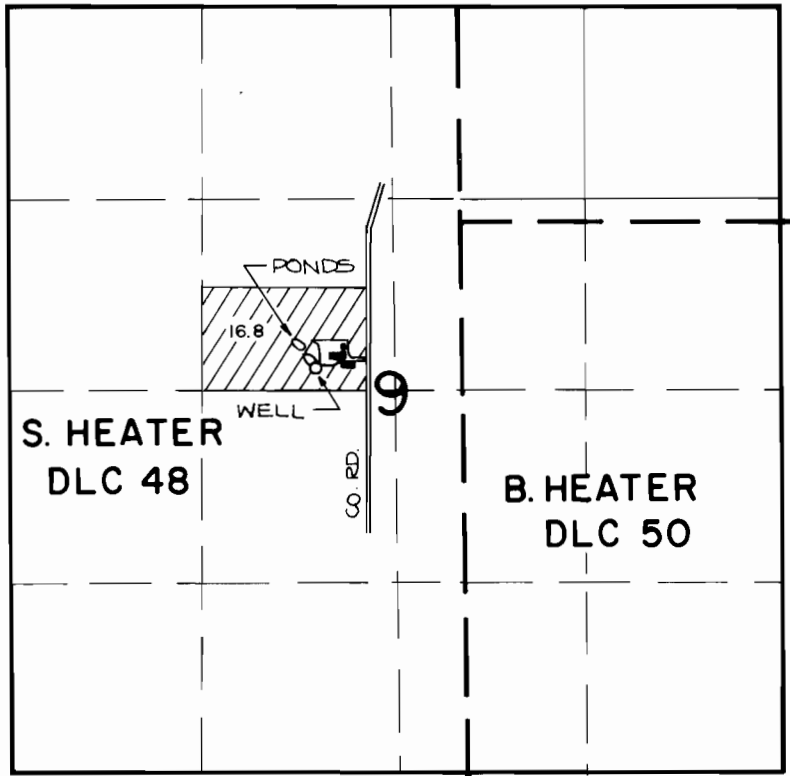

WELL LOCATION: 175 FT. N. AND 550 FT. W. FROM THE CENTER OF SECTION 9.



SCALE: 4" = 1 MILE

FINAL PROOF SURVEY
UNDER

Application No. G-10780 Permit No. G-9861.....
IN NAME OF

.....**GLEN W. MILLS**.....

Surveyed NOV...9... 1984., by P. Pagten.....