


T. 3S., R. 1W., W.M.

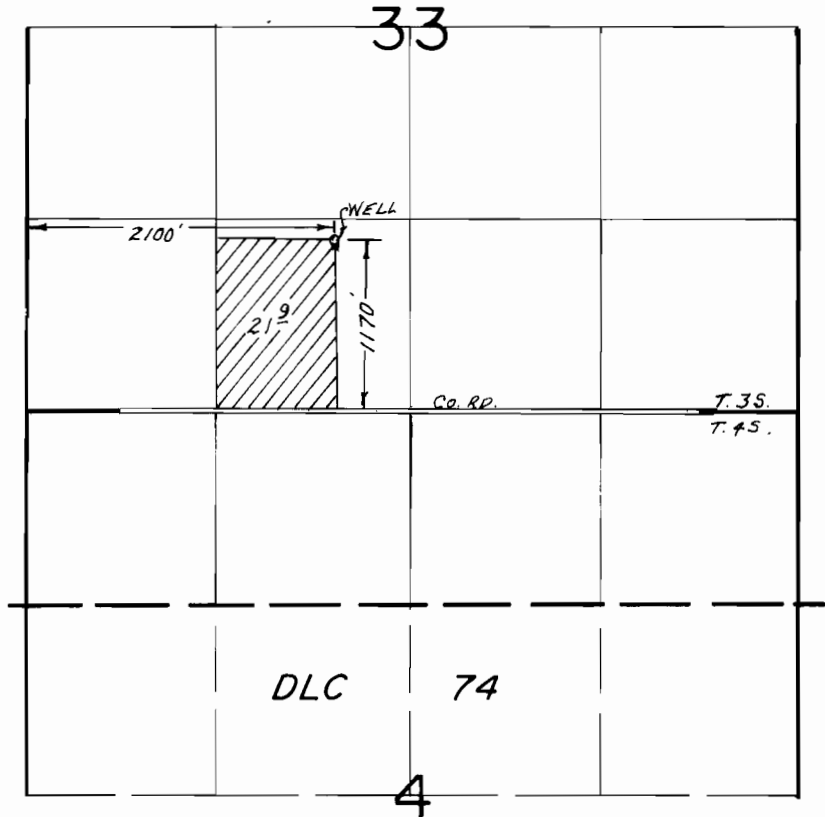

**FINAL PROOF SURVEY**  
UNDER

Application No. G-10782. Permit No. G-9862.....  
IN NAME OF

.....MIKE FIGINI.....

Surveyed Sept. 8..... 19.83., by L.M. TOLL.....