


G-9904
63761

T. 4 N. R. 25 E. W.M.

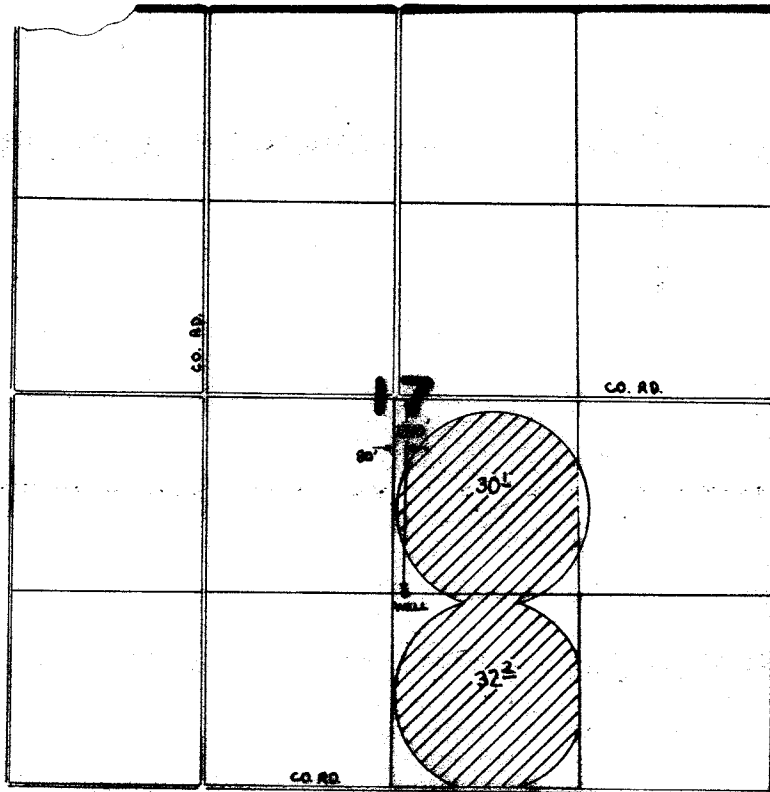

FINAL PROOF SURVEY UNDER

Application No. G.10807. Permit No. G9904....
IN NAME OF

GLEN G. & MARGARET M. MOORE

Surveyed Jan. 30.... 1987., by V. Church.....