
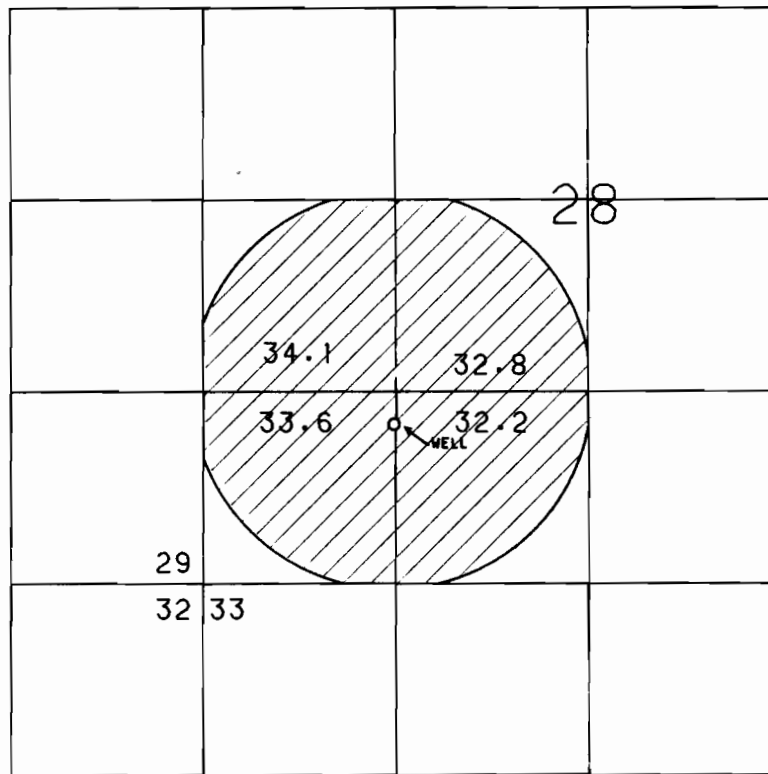


T 23 S, R 33 E, WM

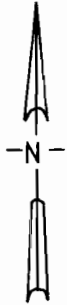

WELL LOCATED: 1070 FEET NORTH AND 1300 FEET EAST FROM THE SW CORNER SECTION 28.

SCALE: 1 IN = 1320 FT

FINAL PROOF SURVEY
UNDER

APPLICATION NO. G-10816 PERMIT NO. G-9908
IN THE NAME OF

LOUIE FARMS INC.

SURVEYED MAY 21 , 1986, BY L. M. TOLL

PTS 1986-V-A