
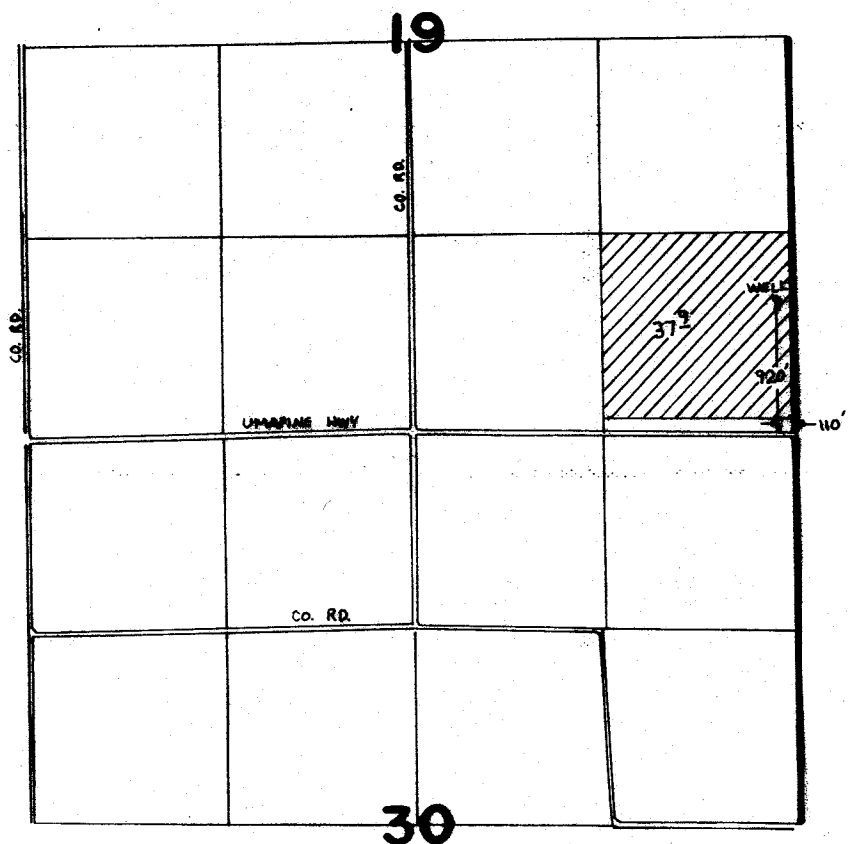


G-9918
63753

T. 6 N. R. 35 E. W.M.

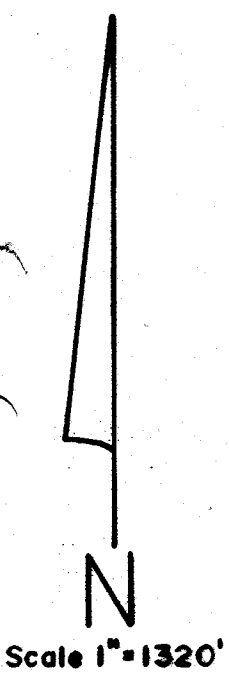

FINAL PROOF SURVEY UNDER

Application No. G.10822. Permit No. G.9918.....
IN NAME OF

DELBERT R. & MARY F. ELLENBERGER

Surveyed March..16. 1987., by V.Church.....