


T.6S., R.2W, W.M.

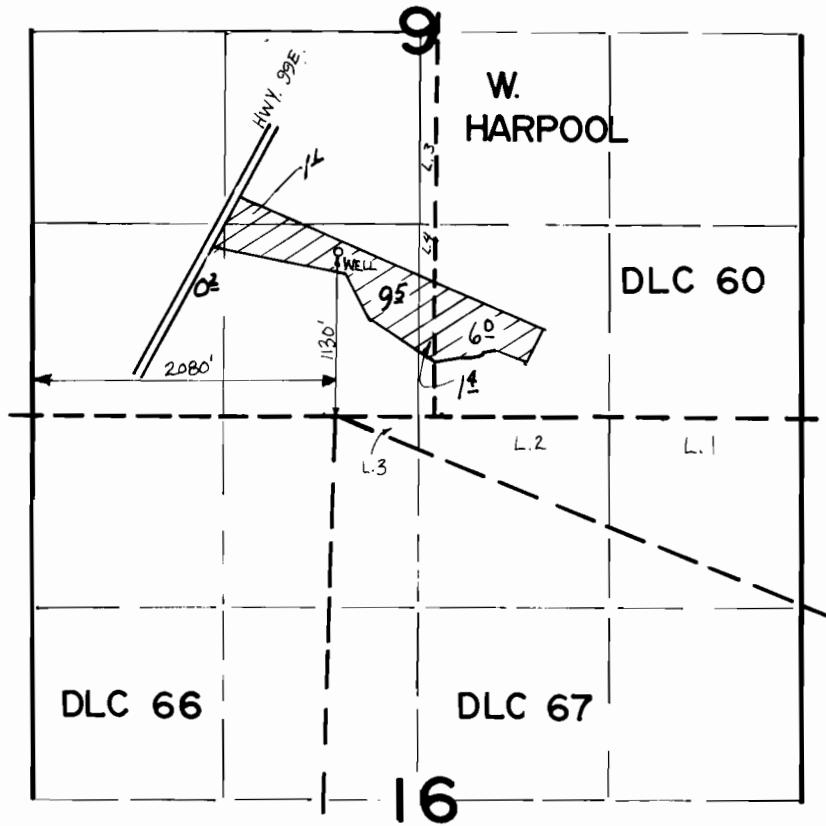

FINAL PROOF SURVEY
UNDER

Application No. G 10854 Permit No. G 9965
IN NAME OF

ALMYN C. & ZELLA I. LIEUALLEN

Surveyed OCT. 25 1983, by M. GARULL