


G-9997  
63711

T. 4N., R. 29E., W. M.

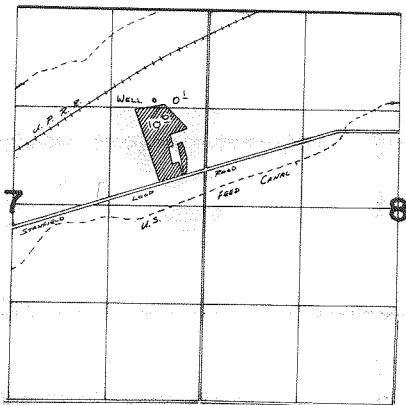

WELL (Pt) LOCATED 1230'S. & 740'W. FROM NE COR. SEC 7

SCALE 1" = 1320'

**FINAL PROOF SURVEY**  
UNDER

Application No. ~~G:10858~~ Permit No. **G:9997**..

IN NAME OF

**DON PECK**

Surveyed ~~✓~~ ~~in~~ ~~U.S.~~ 1986, by ~~K.A. Church~~.....