


# T. 4S., R. 1W., W. M.

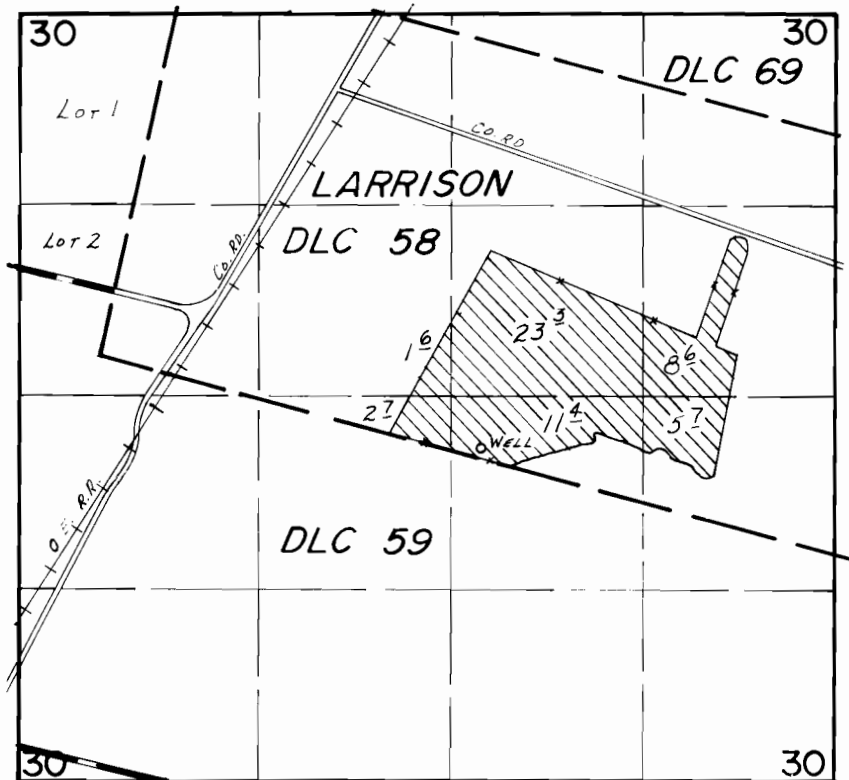

WELL LOC : 350'S. & 200'E. FROM CENTER OF SEC. 30

SCALE: 1"=1320'

## FINAL PROOF SURVEY UNDER

Application No. G:10861. Permit No. G:9967.....  
IN NAME OF

.....ERWIN NYQUIST.....

Surveyed May...1..... 19.84., by B.W. BISHOP.....