


T. 16S., R. 30 & 31E., W. M.

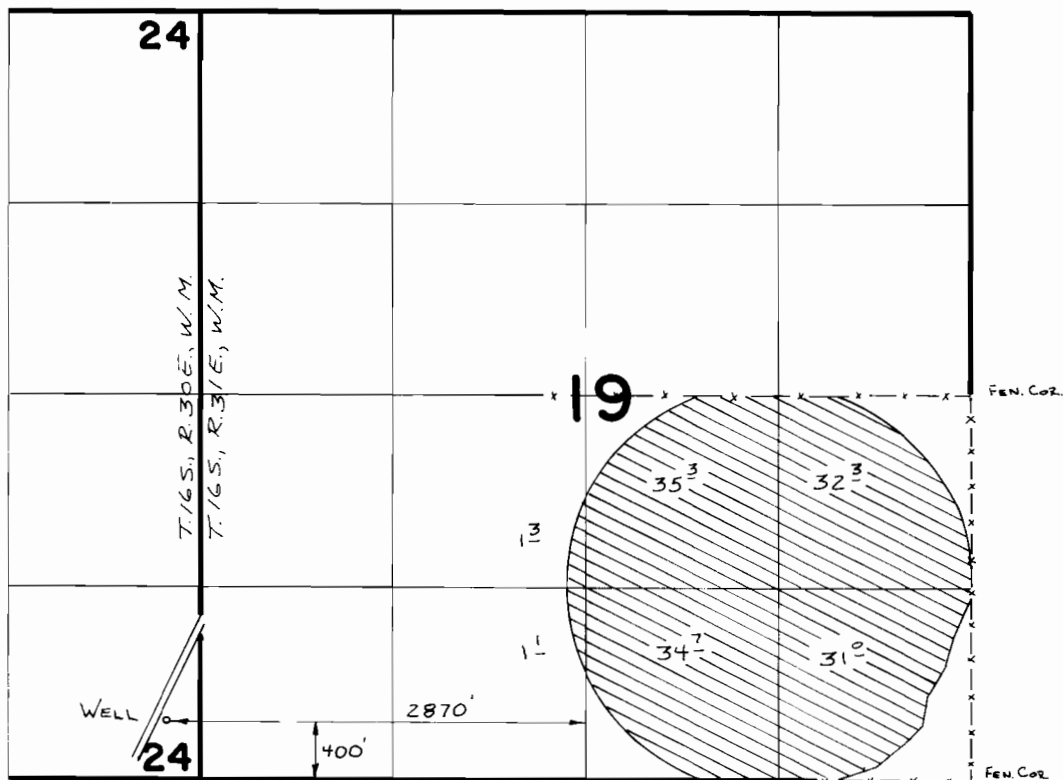

FINAL PROOF SURVEY
UNDER

SCALE: 1" = 100'

Application No. **G:10873** Permit No. **G:10013**
IN NAME OF

H. MARTIN & HELEN L. CARTER

Surveyed 4-9-1986, by L. T. G. H.