


T. 5S., R. 2W., W.M.

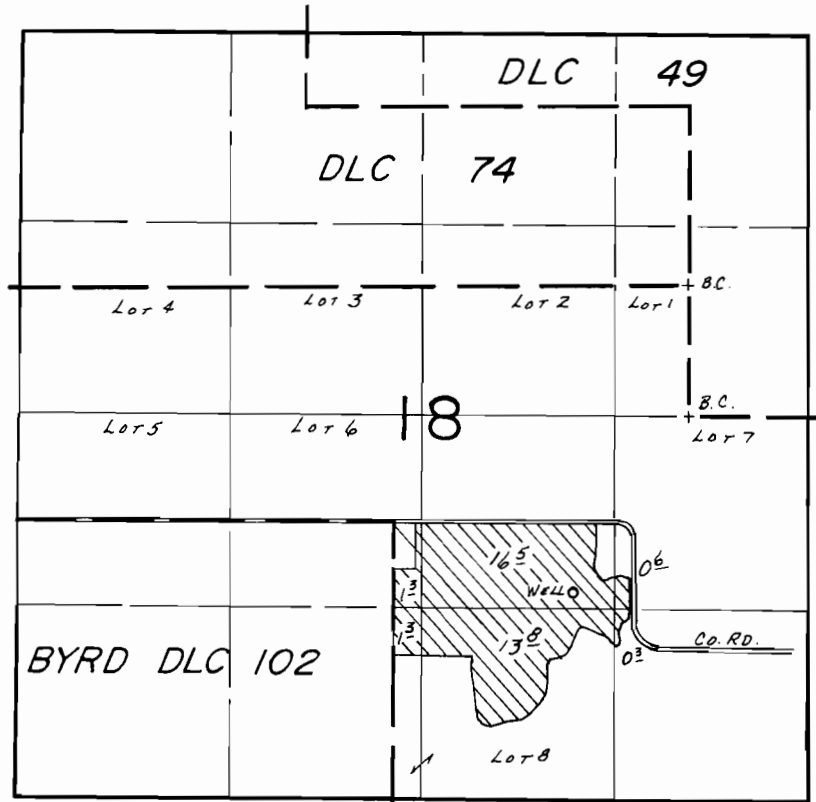

WELL LOC: 490'S. & 1240'E. FROM NE COR. BYRD DLC 102.

SCALE: 1" = 1320'

FINAL PROOF SURVEY
UNDER

Application No. G-10888. Permit No. G-10031.....
IN NAME OF

.....KIRIL KUTSEV.....

Surveyed April 18... 1984, by J.M. WARREN.....