


T.14S.,R.12E.,W.M.

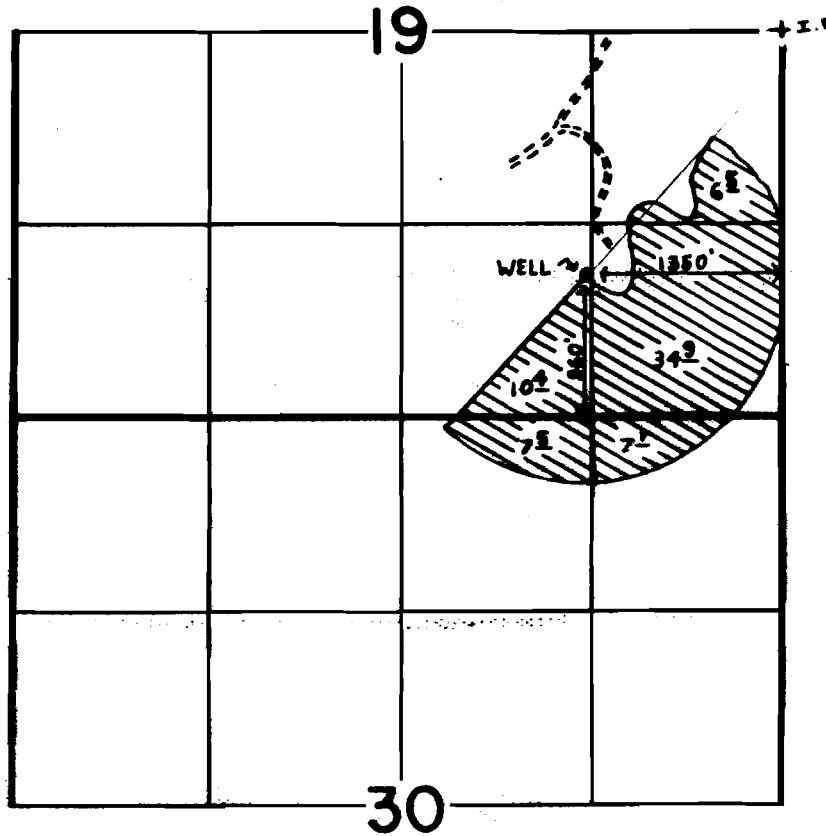

SCALE: 1" = 1320'

FINAL PROOF SURVEY
UNDER

Application No. G-1028.. Permit No. G-10194.....
IN NAME OF

NELSON R. HOWARD

Surveyed SEPT. 20, 1985., by LESLIE OLSON....

Cert. # 63717

RECEIVED
DATE *1-26-90*
WATER MASTER DISTRICT #11
BY *SMJ*

G-10194