


G-10196
63718

T. 3 N. R. 29 E. WM.

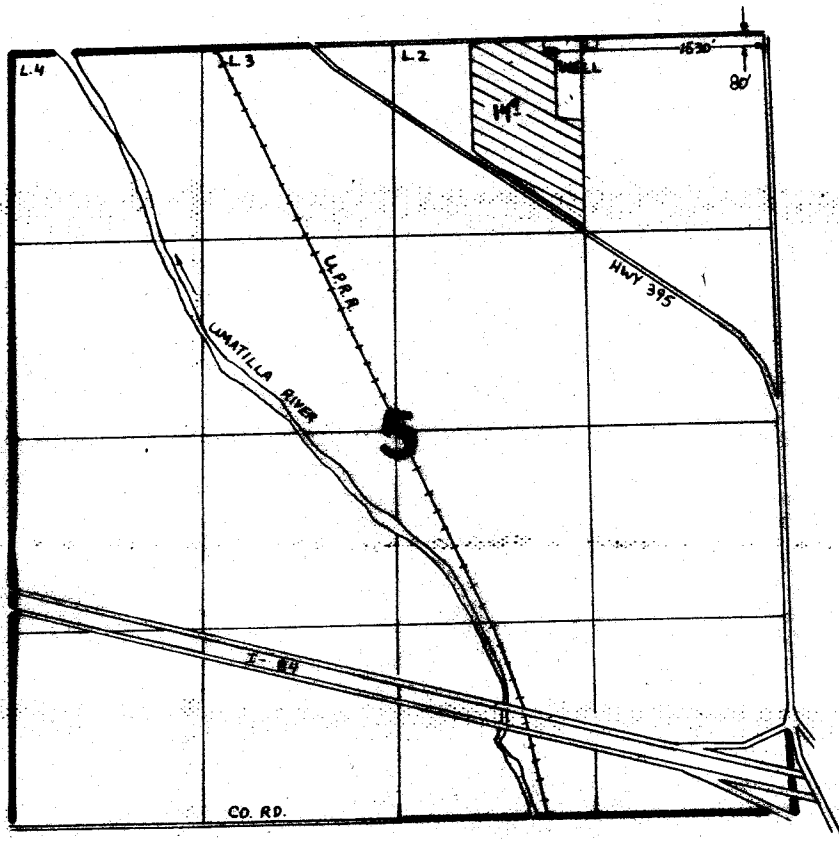

Scale 1" = 1320'



FINAL PROOF SURVEY UNDER

Application No. G11032... Permit No. G10196.....
IN NAME OF

RAY BRADY

Surveyed Oct. 3, 1984, by V. Church