


G-10306  
63719

# T. 2 N., R. 33 E., W. M.

SCALE: 1" = 1320'

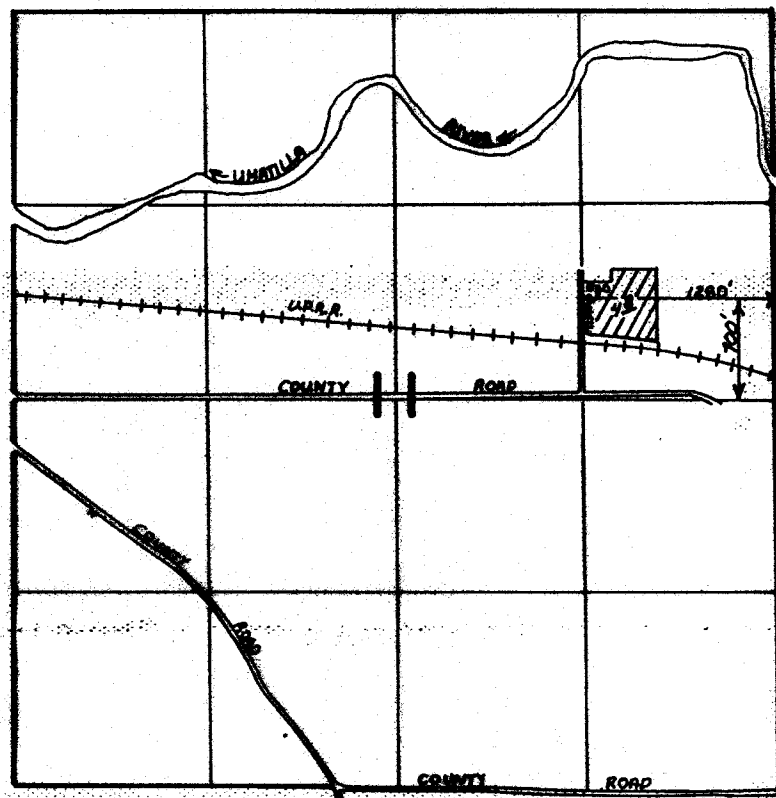

## FINAL PROOF SURVEY UNDER

Application No. G-11136 Permit No. G-10306

IN NAME OF

KERN PICKNELL

Surveyed July 23..... 1986.., by V.L. CHURCH.....

By J.K. SAUTER