


G-10382

63720

# T. 6 N. R. 35 E. W. M.



SCALE: 1"=1320'

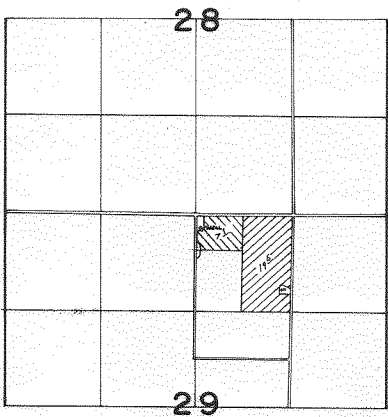

WELL LOCATED 180° S. AND 60° E. FROM N. 1/4 COR. SEC. 29



PRIMARY



SUPPLEMENTAL

## FINAL PROOF SURVEY

UNDER

Application No. G-11142... Permit No. G-10382...  
IN NAME OF

.....KENNETH HART.....

Surveyed ..11:7..... 1987.., by V.L. CHURCH.....