


G-10364
63721

T. 2 N. R. 32 E. W.M.

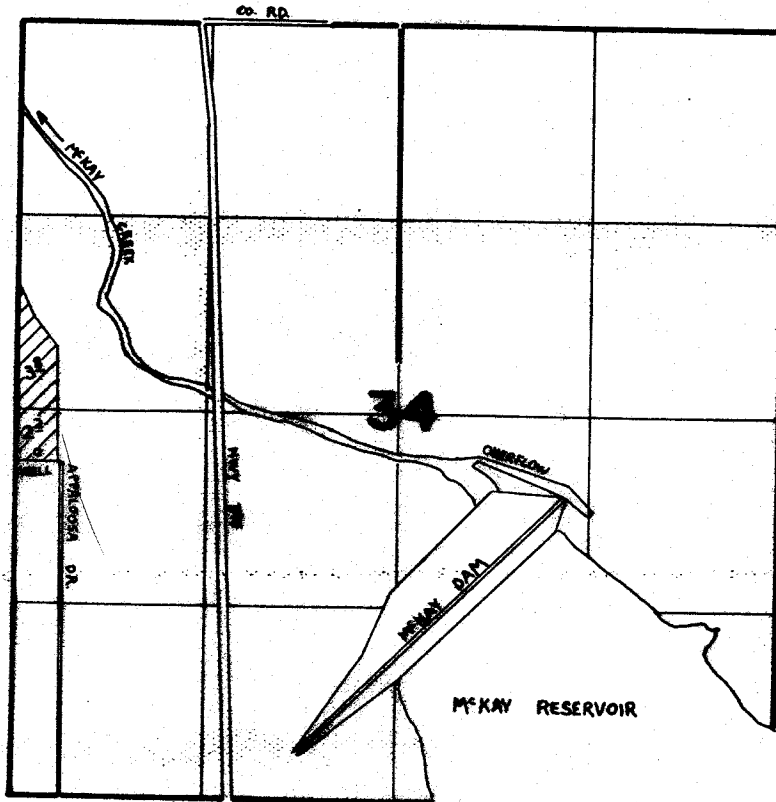

N
Scale 1" = 1320'

WELL LOC. 200' S + 150' E FROM W. 1/4 COR. SEC. 34

FINAL PROOF SURVEY UNDER

Application No. G.11231... Permit No. G.10364...
IN NAME OF

.....RONALD E. HUMISTON.....

Surveyed Nov. 13... 1986, by V. Church.....