


T.6S. R.2W., W.M.

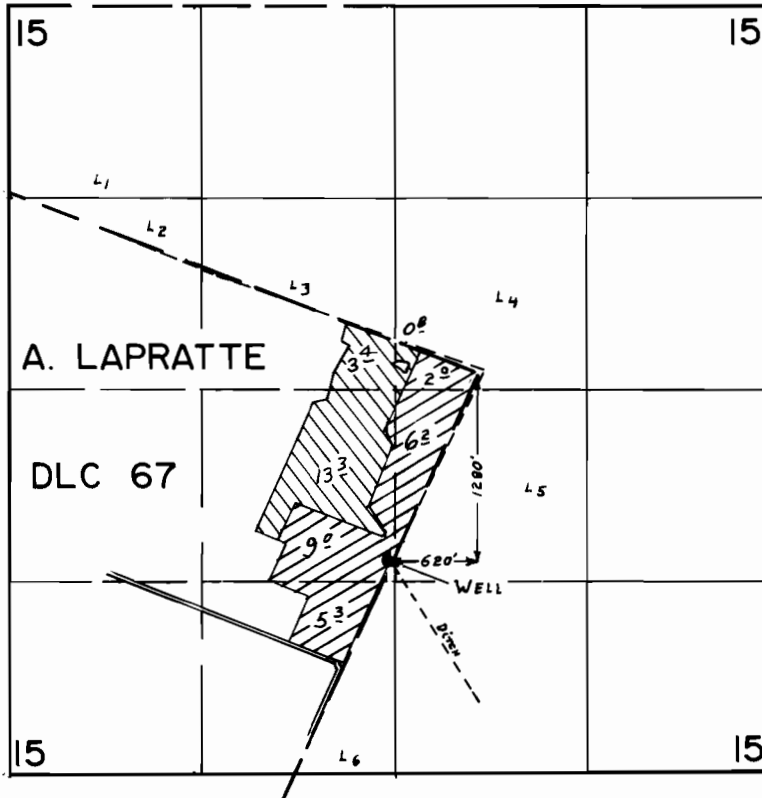

SCALE: 1" = 1320'

FINAL PROOF SURVEY UNDER

G-11236 G-10352 
 Application No. G-7814 Permit No. G-7229 
 IN NAME OF

..... JOSEPH HENNY

Surveyed APR. 25, 1979, by L. H. NUNN.....
 (G-11236) AUG. 2 1984 B.W. BISHOP

4/11/85 BWB