


G-10376
63723

T. 6 N R. 35 E. WM.

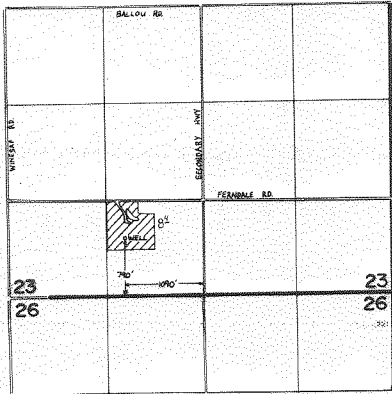

FINAL PROOF SURVEY UNDER

Application No. G11253... Permit No. G10376.....
IN NAME OF

JOHN P. YOUTZ

Surveyed May 8, 1986, by J. Souler.....