


T.41S., R.21E., W.M.

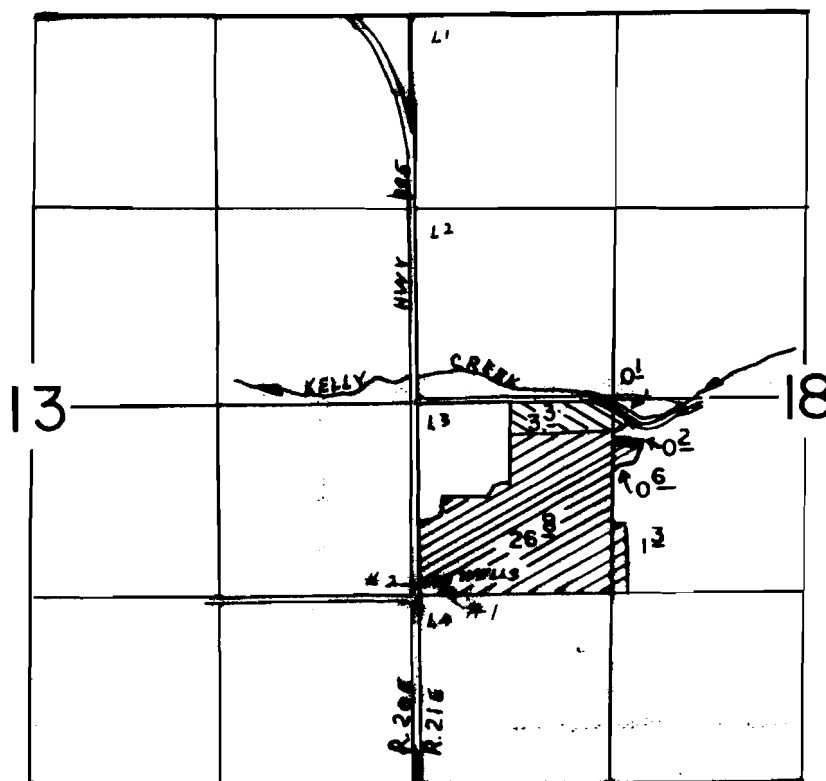

2.16 ACRES

Wells Located, No.2-1400' N & 100' E, No.1-1420' N & 175' E, Both From SW Corner Section 18

SCALE: 1"=1320'



FINAL PROOF SURVEY UNDER

Application No. G-11396. Permit No. G-10522....
IN NAME OF

C. HUGH GILLMORE

Surveyed OCT. 16, 1987, by V.L. CHURCH