


T. 5 S., R. 4 W., W. M.

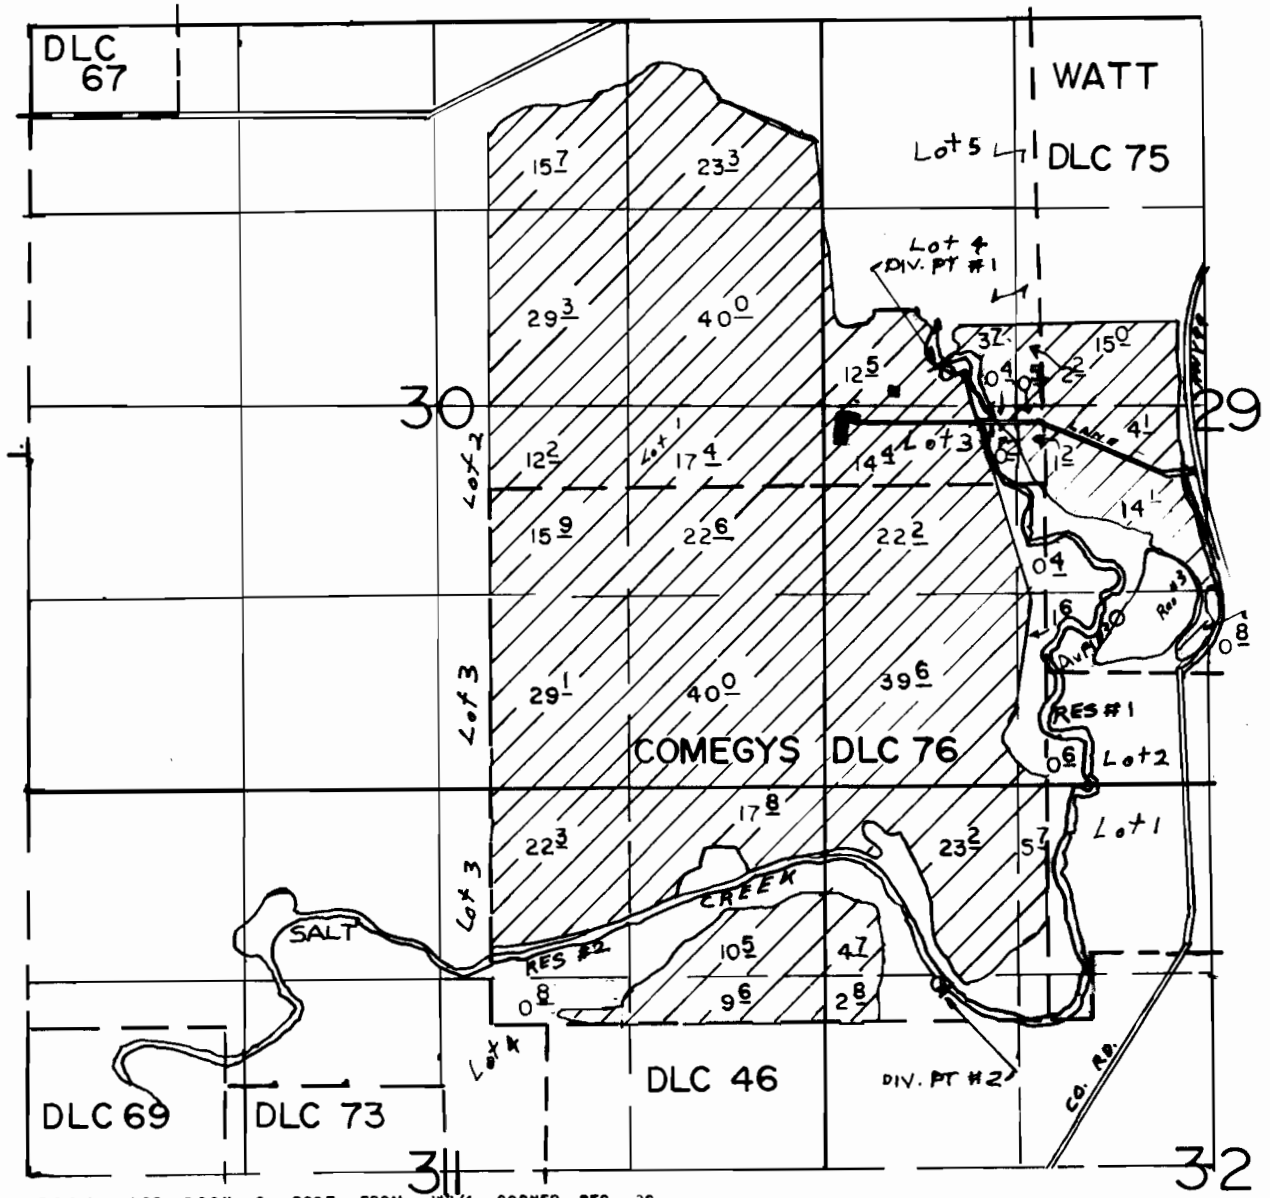

POD 1 LOC 300N & 800E FROM W 1/4 CORNER SEC 29
 POD 2 LOC 1400S & 760E FROM SW CORNER SEC 29
 POD 3 LOC 1140N & 2000E FROM SW CORNER SEC 29

SCALE: 1"=1320'

FINAL PROOF SURVEY

UNDER

R-59347 R-8166
 59348 45015
 R-53839 R-6437

Application No. 53840.... Permit No. 40390.....

IN NAME OF

ROY & MARY ANNE FREEMAN.....

Surveyed OCT. 7..... 1983., by ..R. PAGTER.....
 SEPT 1 1988 ZEIDAN SALEH