T.17S. R.3W. W.M.

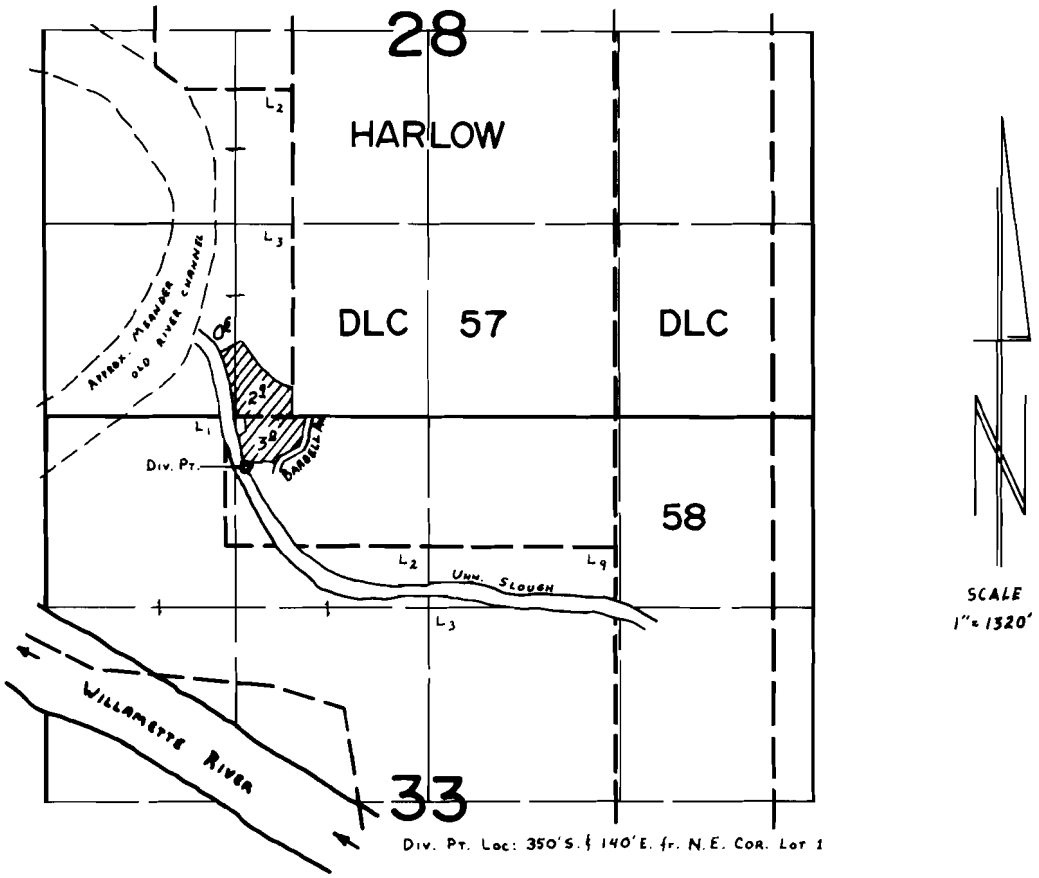

FINAL PROOF SURVEY
UNDER

Application No. 54741 Permit No. 41064
IN NAME OF

ROBERT A. MELTEBEKE

Surveyed June 17, 1980, by C. L. Hughes

RWK (UPDATE)
PTS W/FF
PTS-1980-J