


T. 12 & 13 S., R. 5 W., W. M.

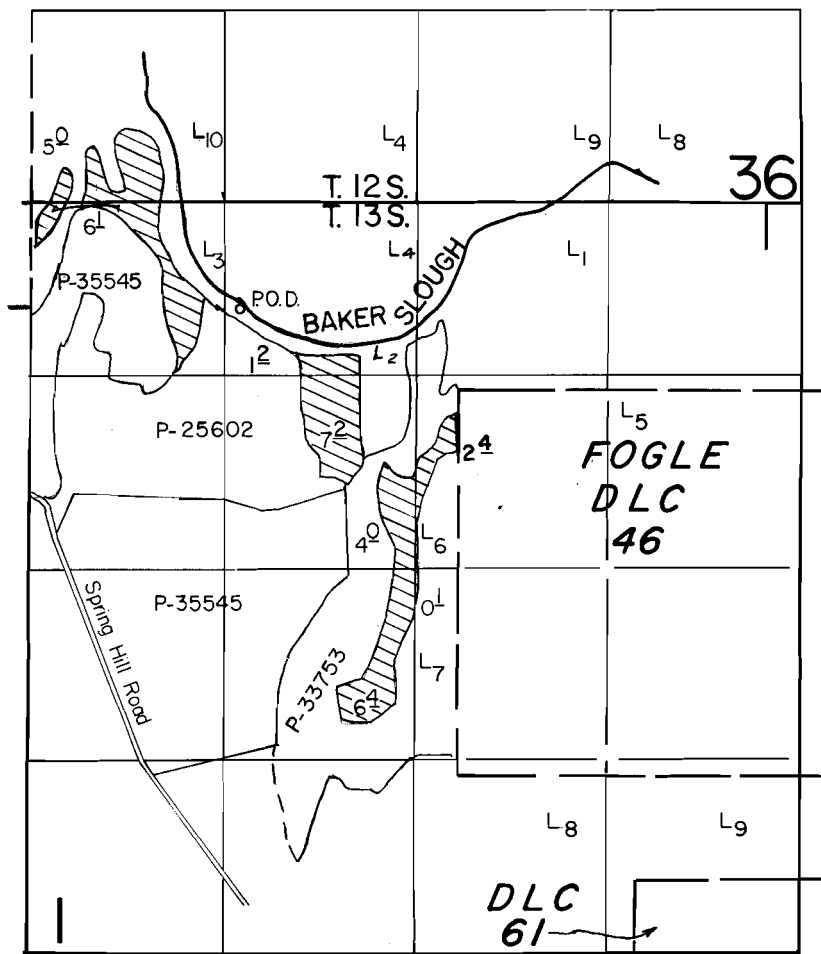

P.O.D. Loc.: 550' N. & 1500' W. from NW Cor. DLC 46.

Scale: 1" = 1320'

FINAL PROOF SURVEY UNDER

Application No. 56041 Permit No. 48266
IN NAME OF

CARL LOVELADY

Surveyed NOV. 20 1987, by T. WARREN