


T2N, R12E, WM

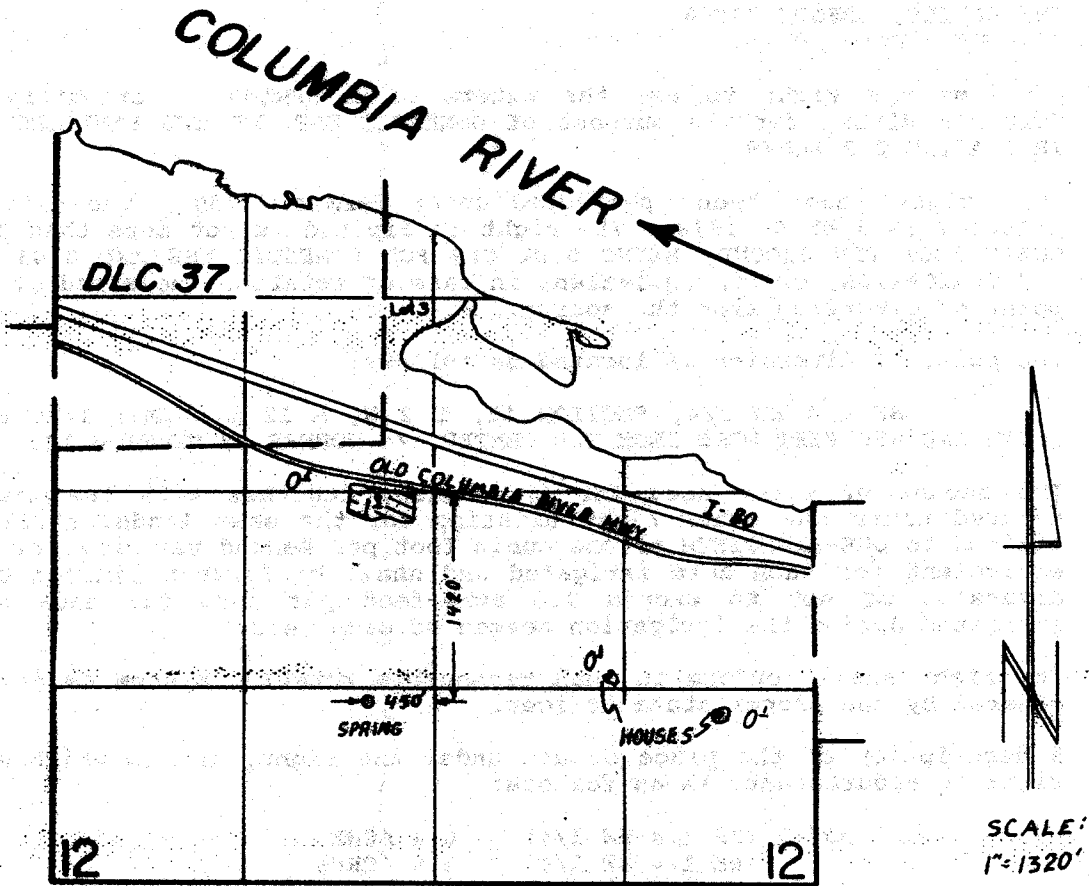

FINAL PROOF SURVEY
UNDER

Application No. 57488. Permit No. 43250...
IN NAME OF

ROBERT A. & JANICE M. STAYER

Surveyed APRIL 12, 1988, by T.M. WARREN...

RWK
41065 179 235R