
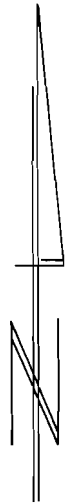


T14S, RIW, WM

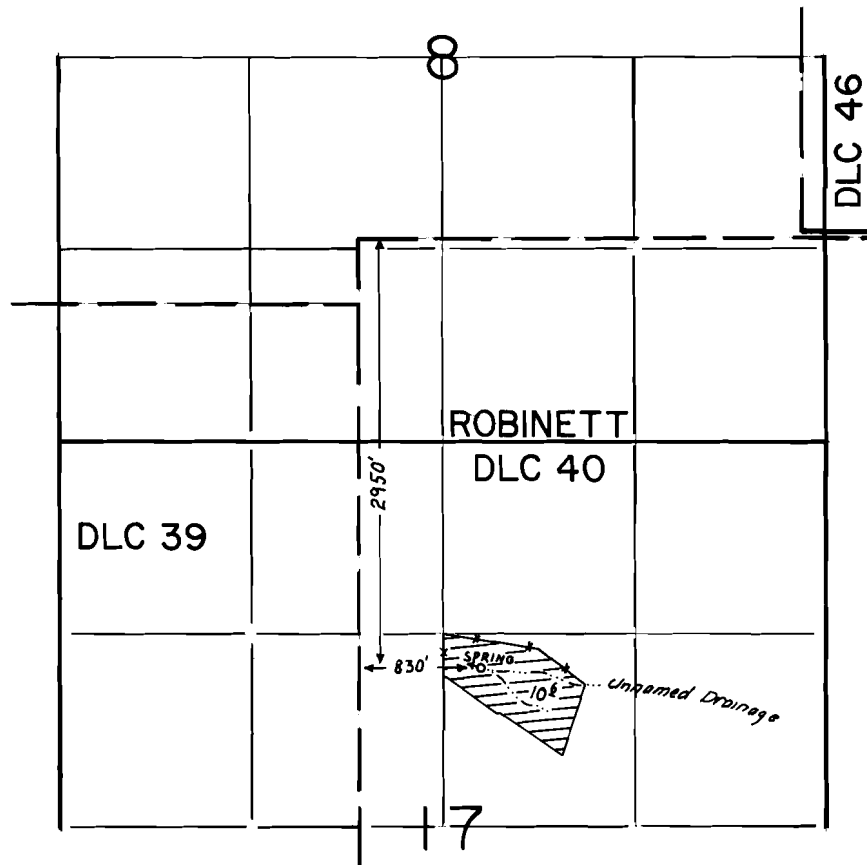

SCALE
1" = 1320'

FINAL PROOF SURVEY UNDER

Application No. 58929 Permit No. 44408....
IN NAME OF

ALICE PRATT.....

Surveyed SEPT. 12. 1988. by T.M. WARREN...