T. 5 S., R. 4 W., W. M.

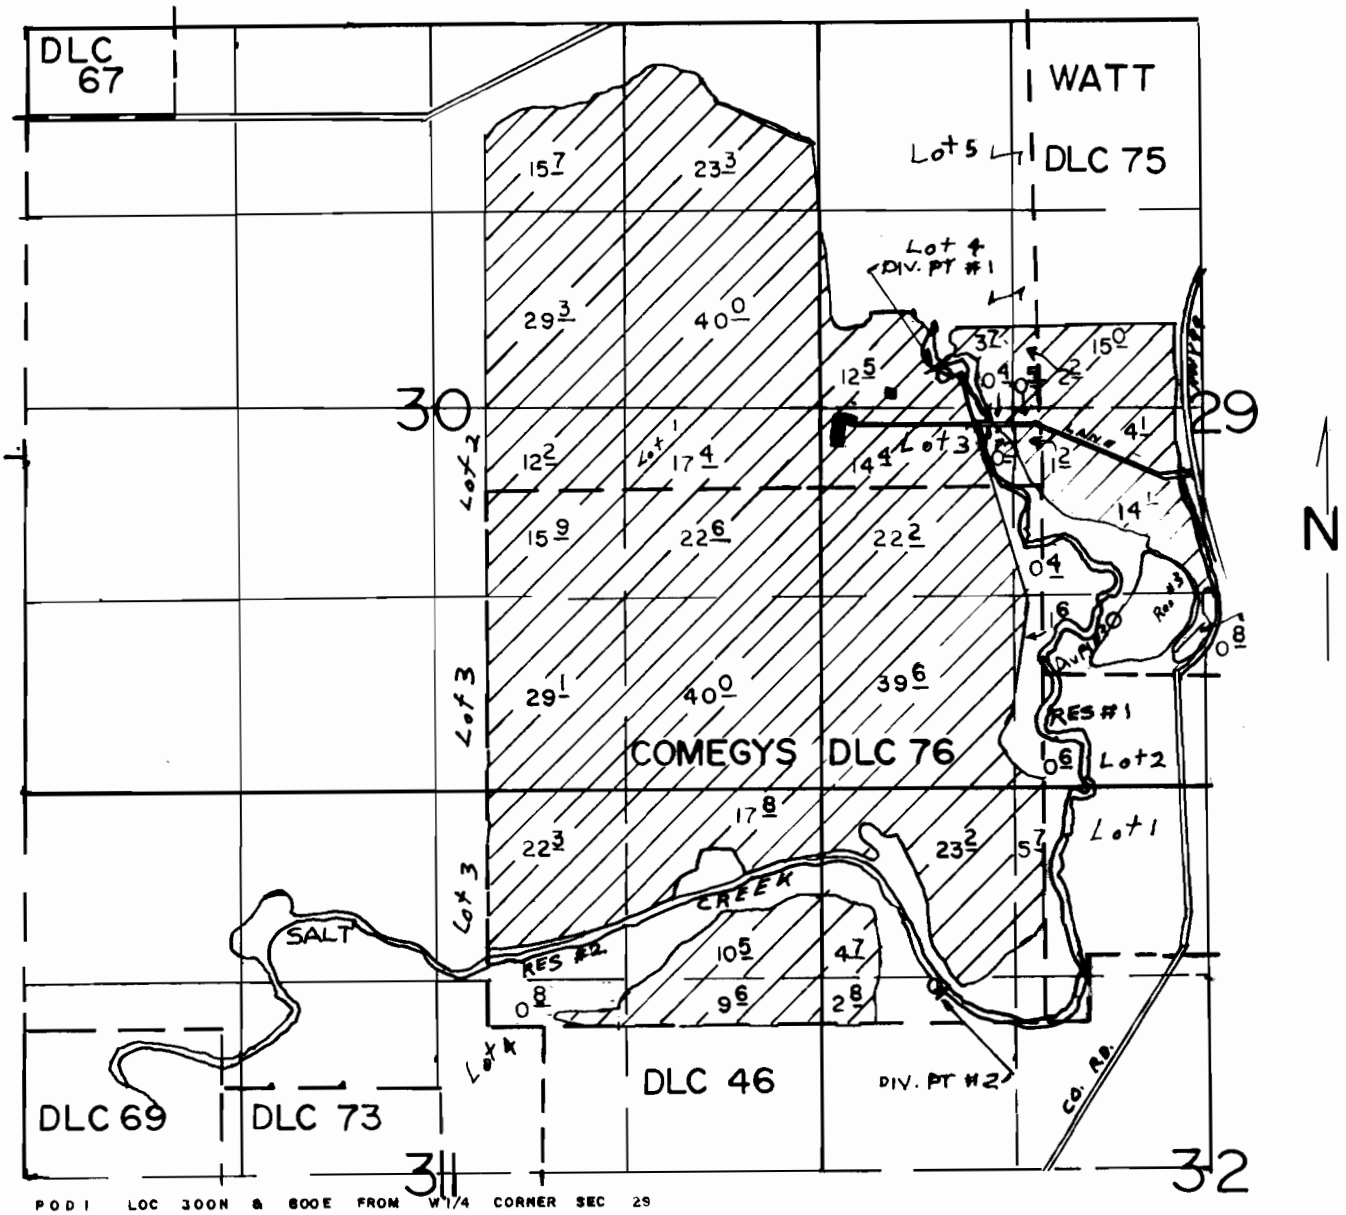

POD 1 LOC 300N & 600E FROM W1/4 CORNER SEC 29
POD 2 LOC 1400S & 750E FROM SW CORNER SEC 29
POD 3 LOC 1140N & 2000E FROM SW CORNER SEC 29

SCALE: 1" = 1320'

FINAL PROOF SURVEY

UNDER

R-59347 R-8166
59348 45015
R-53839 R-6437

Application No. 53840.... Permit No. 40390.....

IN NAME OF

ROY & MARY ANNE FREEMAN.....

Surveyed OCT 7.....1983., by P. PAGTER.....
SEPT 1 1988 ZEIDAN SALEH