
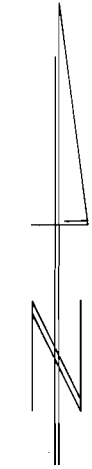


T16S, R2E, WM

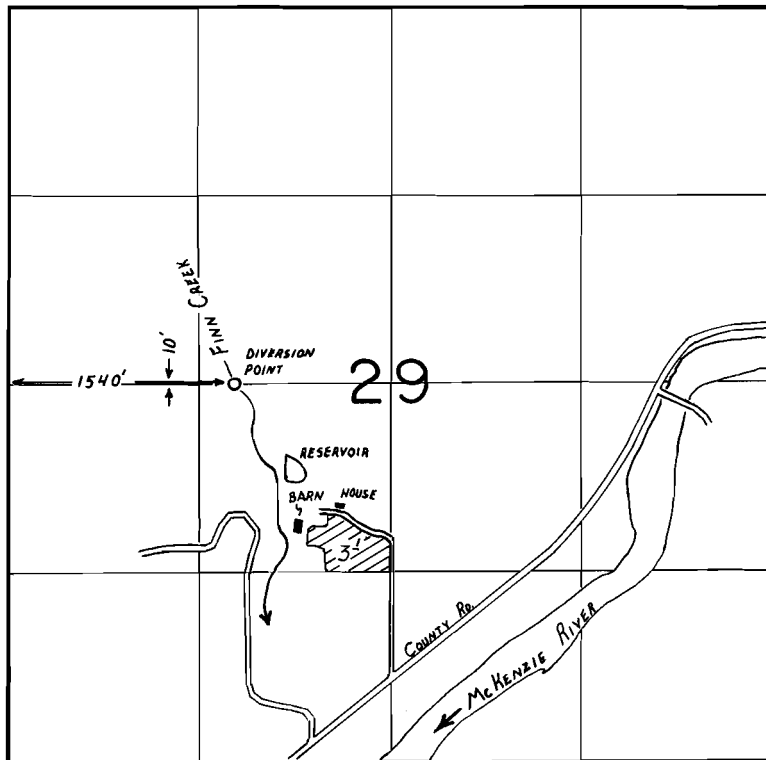

SCALE
1" = 1320'

FINAL PROOF SURVEY UNDER

R-59754 R-8137
 Application No. 59755... Permit No. 44893...
 IN NAME OF

BILL HILL L. G. CAMPBELL COMPANY

Surveyed APRIL 20 1988, by T. M. WARREN..