


T.5S., R.3&4W., W.M.

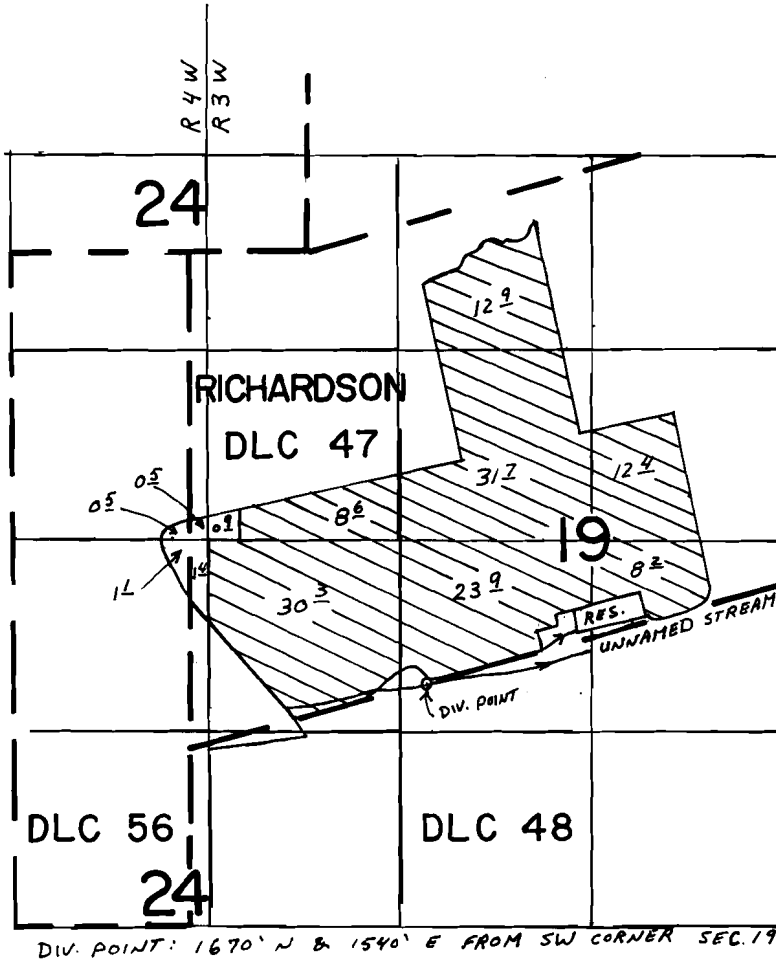

SCALE 1" = 1320'

FINAL PROOF SURVEY UNDER

R-60246 R-8461

Application No. 60247 Permit No. 46838
IN NAME OF

SHAD - O - HILL FARMS, INC.

Surveyed SEP. 7 1988, by ZEIDAN F. SALEH