


# T.5S., R.3&4W., W.M.

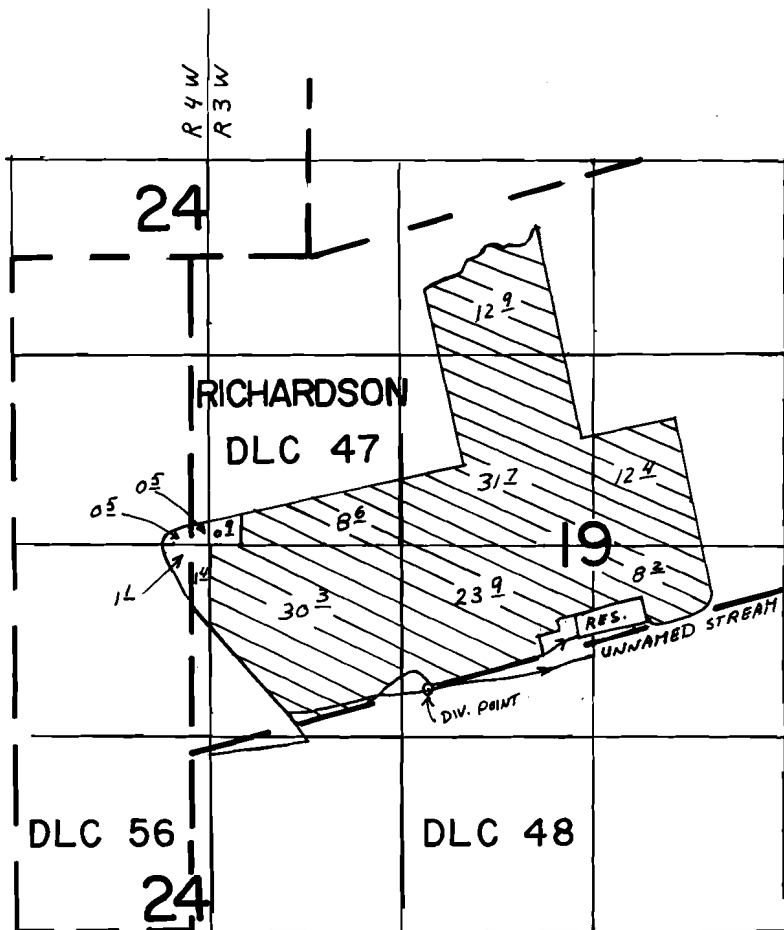

DIV. POINT: 1670' N & 1540' E FROM SW CORNER SEC.19

SCALE 1" = 1320'

## FINAL PROOF SURVEY UNDER

R-60246                      R-8461

Application No. **60247**    Permit No. **46838**  
IN NAME OF

**SHAD - O - HILL FARMS, INC.**

Surveyed **SEP. 7** 19**88**, by **ZEIDAN F. SALEH**