


# T.3S., R.40E., W.M.

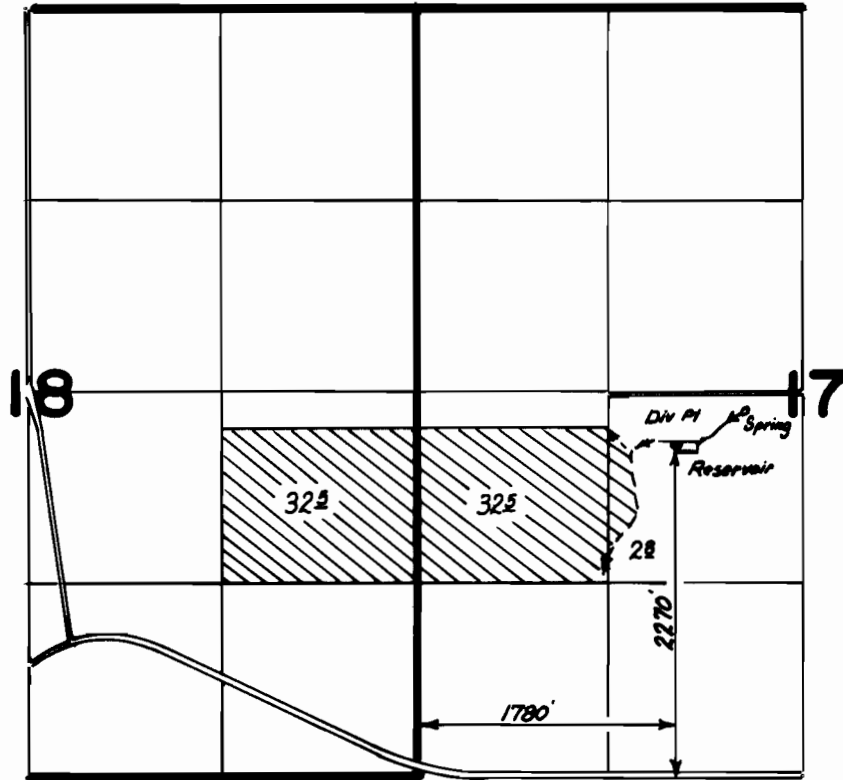

Scale: 1" = 1320'

## FINAL PROOF SURVEY UNDER

R-63586                      R-8530  
 Application No. 60581... Permit No. 47145.....  
 IN NAME OF

**JAMES R. & REBECCA J. NORTON**

Surveyed 7-21-1987, by Vern Church.....