
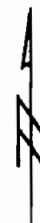


T.3S., R.40E., W.M.

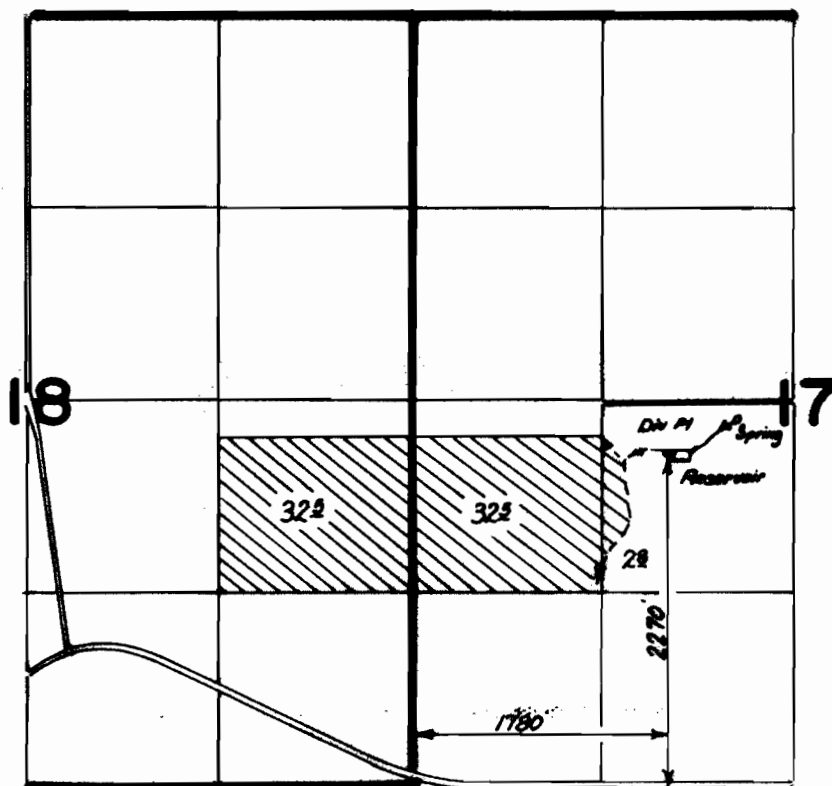

Scale: 1" = 1320'

FINAL PROOF SURVEY UNDER

R-63586 R-8530
Application No. 60581... Permit No. 47145.....
IN NAME OF

JAMES R. & REBECCA J. NORTON

Surveyed 7-21-1987, by Vern Church.....