


T. 12S., R. 5W., W.M.

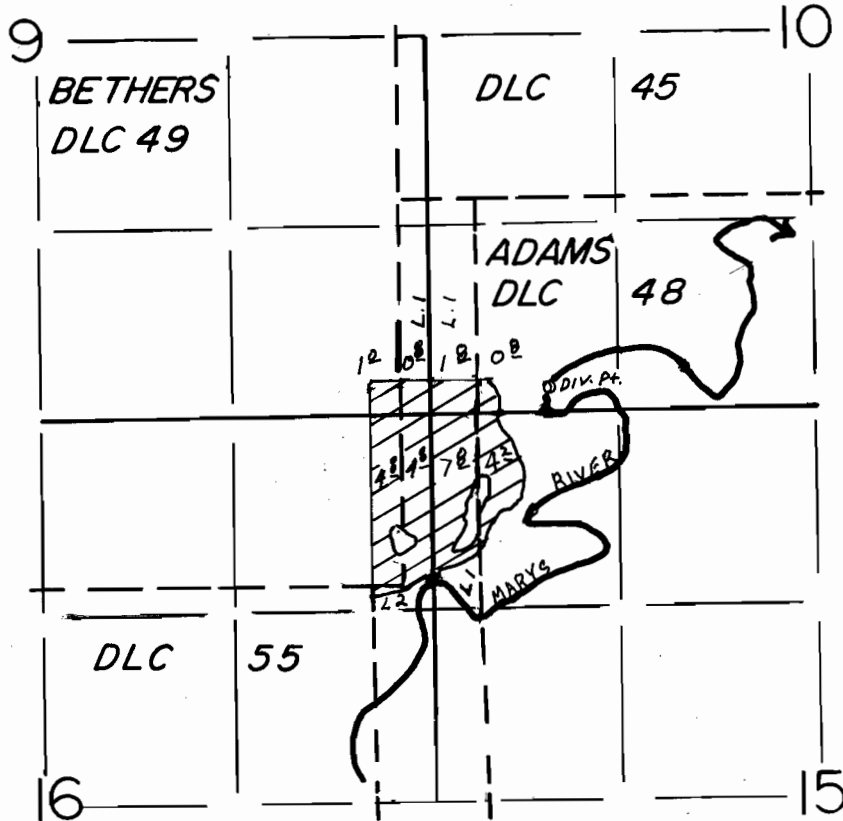

DIV. PT. LOCATED 200' N. & 750' E. FROM THE S.W. COR. SEC 10

FINAL PROOF SURVEY
UNDER

Application No. ~~60965~~..... Permit No. ~~45432~~.....
IN NAME OF

.....**BRUCE & GLORIA LIGHTHART**.....

Surveyed **AUG. 25**... 1988., by **T.M. WARREN**.....