


T.7S., R.48E., W.M.

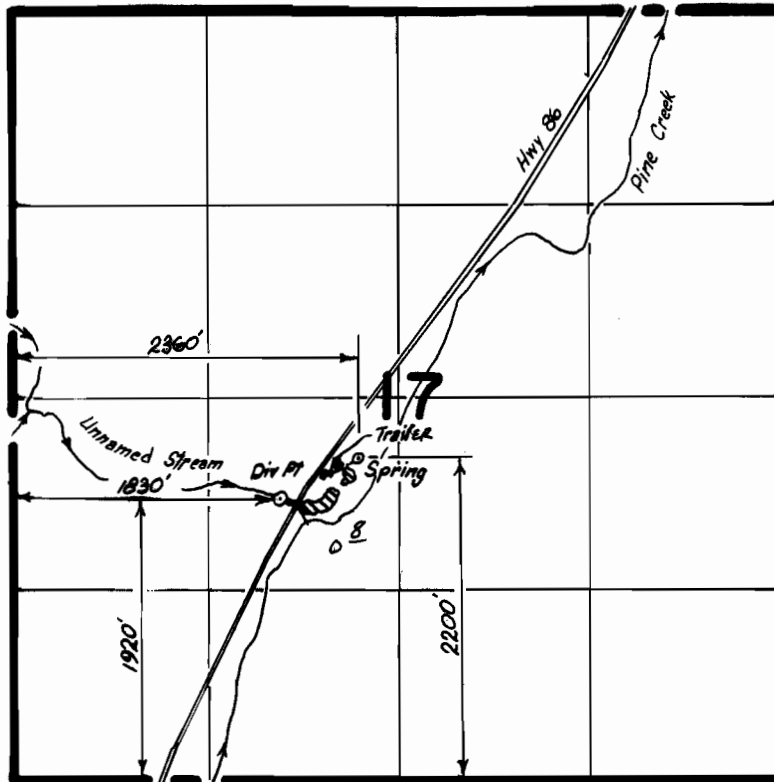

Scale : 1" = 1320'

FINAL PROOF SURVEY UNDER

Application No. 61361 Permit No. 46001
IN NAME OF

DON E. MAKINSON

Surveyed 10-3 1988, by Kenn Kemp