


# T1&2N, R14E, WM

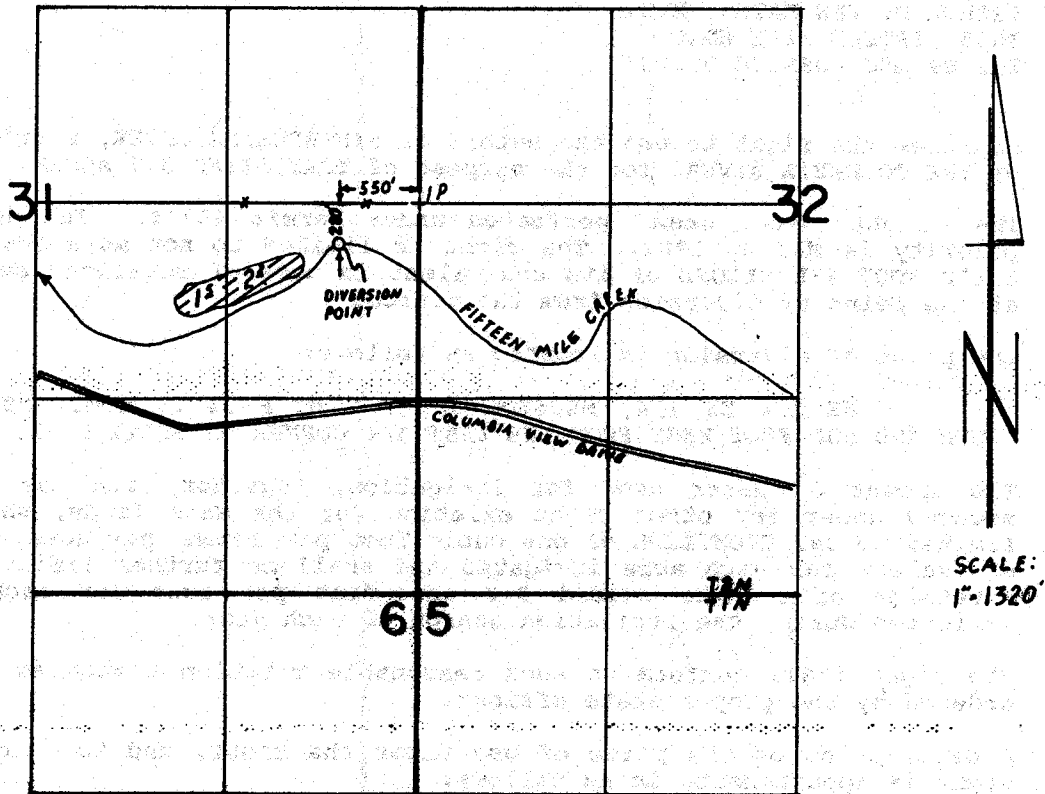

## FINAL PROOF SURVEY UNDER

Application No. 61639... Permit No. 45744.....  
IN NAME OF

...ARTHUR...H...VANEATON,...M.D....

Surveyed APRIL 14, 1988, by T.M. WARREN...