


T. 40 S., R. 14 W., W.M.

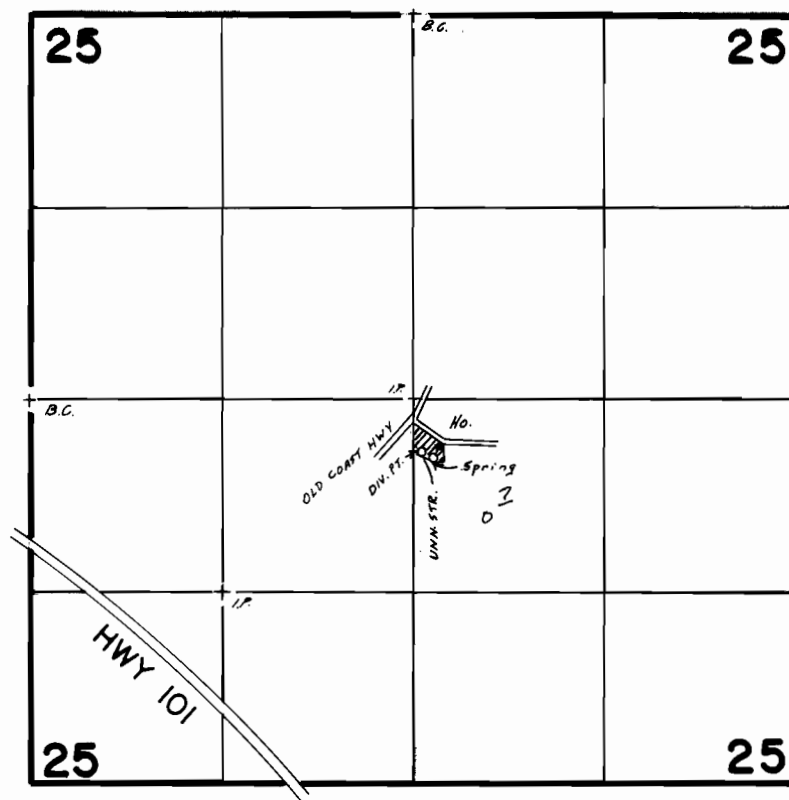

Scale 1" = 1320'

UNNAMED STREAM: 360' S & 50' E BOTH FROM C 1/4.
 SPRING: 400' S & 130' E

FINAL PROOF SURVEY UNDER

Application No. 61776... Permit No. 45931.....
 IN NAME OF

ARTHUR L. HEWITT.....

Surveyed Sept. 29, 1987, by B.S. JAMES.....