


T. 40 S., R. 3 W., W. M.

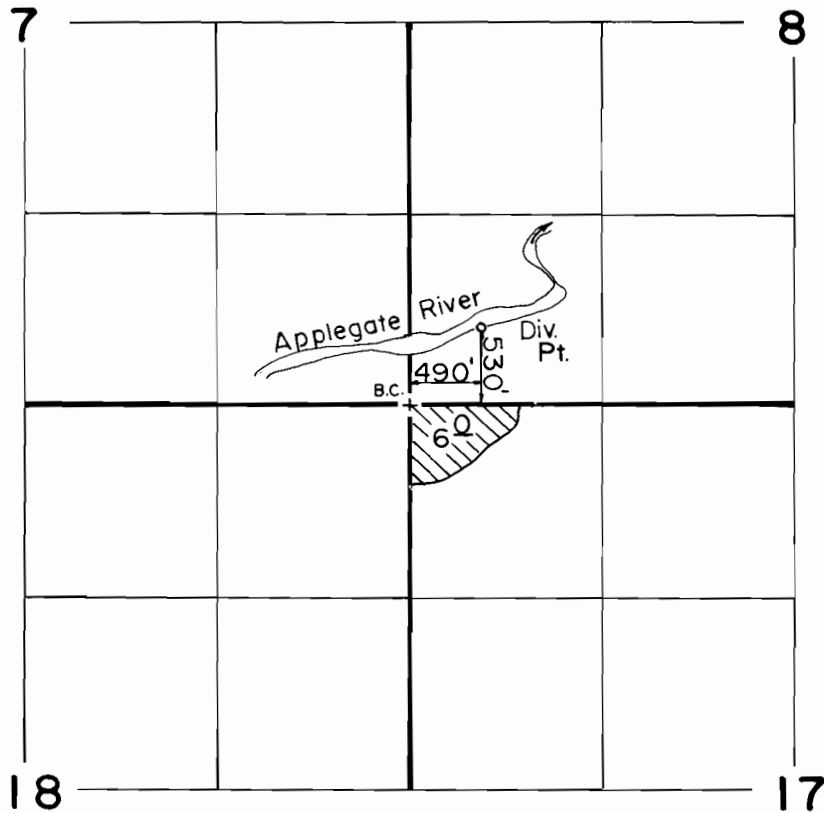

Scale: 1" = 1320'

**FINAL PROOF SURVEY**  
UNDER

Application No. 61902 Permit No. 45886...  
IN NAME OF

JAMES H. FOSSEN

Surveyed NOV...2... 19.87., by B...S...JAMES...