


T.8S., R.46E., W.M.

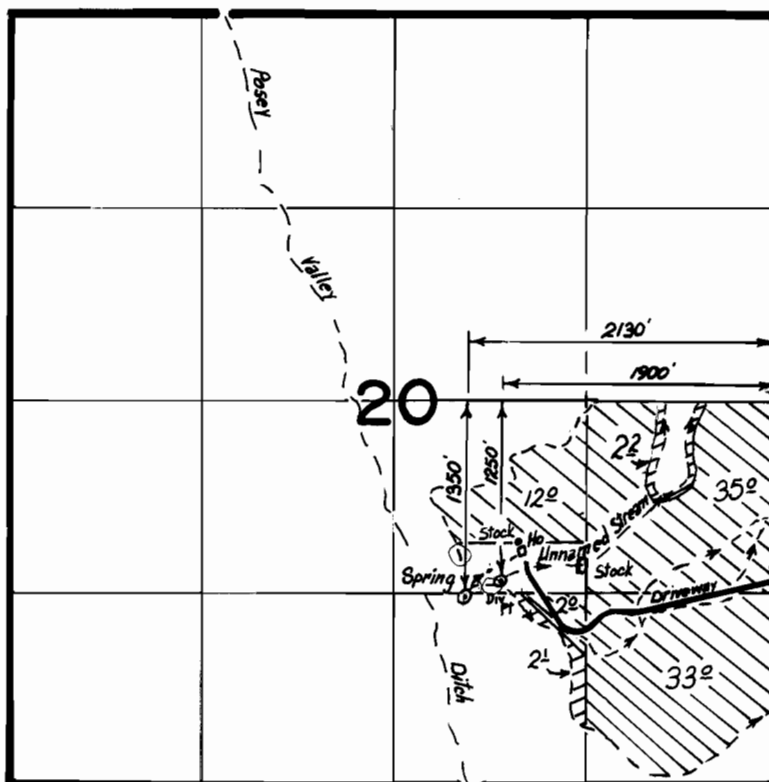

Scale: 1" = 1320'

FINAL PROOF SURVEY
UNDER



Primary



Supplemental

Application No. 62171..... Permit No. 46382.....
IN NAME OF

DONALD E. THATCHER.....

Surveyed 8-24..... 1988., by Kenn. Kemp.....