


RECEIVED

AUG 19 1981

WATER RESOURCES DEPT  
SALEM, OREGON

T.37 S., R.5 W., W.M.

Application No. 62386  
Permit No. 46739

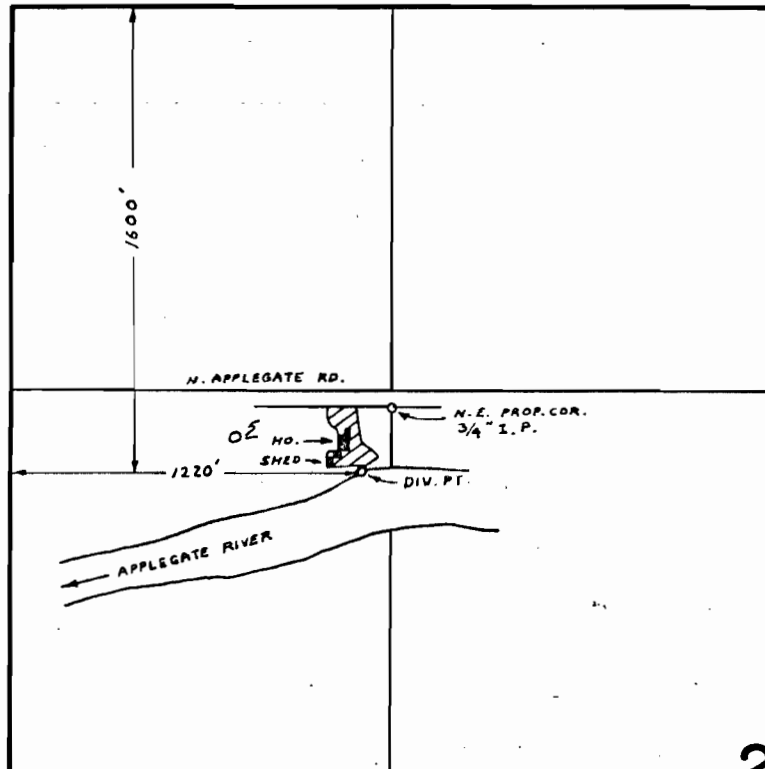

21

SCALE : 1" = 660 FT.

FINAL PROOF SURVEY  
UNDER

RECEIVED

NOV 12 1981

WATER RESOURCES DEPT  
SALEM, OREGON

Application No. 53837 Permit No. 40185  
IN NAME OF

C. W. EILERT

Surveyed JUL. 14 1978. by B. SUND